

Prentiss
K2001
5-67

MISSISSIPPI
BOARD OF WATER COMMISSIONERS
416 North State Street
Jackson, Mississippi 39201

WATER WELL DRILLERS LOG

MAY 4 1967 Bonds Plumbing Drilling Co. Prentiss
date/well completed firm name county well located

LANDOWNER: Eskin Young
Route 4

description of formations encountered	from	to
Sandy / GA m	0'	4'
Red sand	4'	16'
yellow coarse sand	16'	24'
gray sand	24'	29'
Blue clay	29'	190'
" " / shells	190'	212'
Water Bearing sand	212'	260'


OWNER: Mr. Miss.
(mailing address)

WELL LOCATION:
sec. 12 T. 6 N. R. 7 E.
5 miles S of Barnesville
(distance) (direction) (nearest town)

WELL PURPOSE: Home
(home, irrigation, municipal, industrial)

WELL COMPLETION DATA:


- (1) diameter (inches) 4"
- (2) total depth (feet) 260'
- (3) static water level (feet) 105' below above top of ground.
- (4) casing BK steel, 30" x 4"
(material) (depth)
4" if telescope see back.
(size)
- (5) screen none
(length) (depth to top)
(size) (material)
- (6) pump did not install
(type power) (yield gpm)
- (7) electric log no
(yes or no)
(organization running log)
- (8) how well bottom plugged open

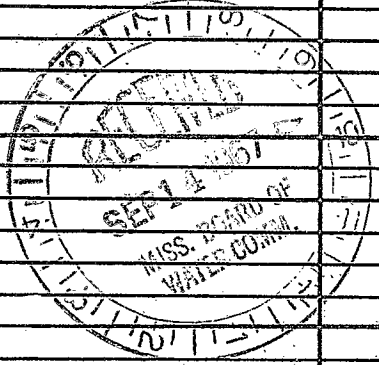

DRILLERS REMARKS:

If well telescopes please sketch and show depths.

GROUND LEVEL

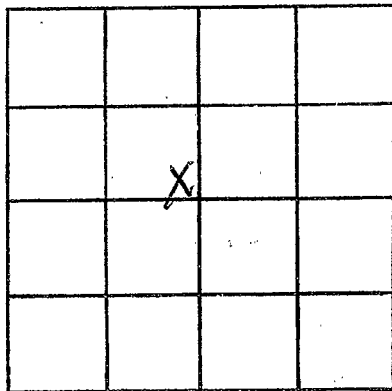

SECTION 12

Please indicate well location X.

ADDITIONAL INFORMATION

If more than one screen,
show locations of each on sketch.