

Prentiss
 K 2000
 10-67

MISSISSIPPI
 BOARD OF WATER COMMISSIONERS
 416 North State Street
 Jackson, Mississippi 39201

WATER WELL DRILLERS LOG

Oct 11 1967 date well completed
 Bond, Plumkington, DeKalb firm name
 Prentiss county well located


LANDOWNER: Jessie Oswald
 Wheeler Miss
 (mailing address)

description of formations encountered	from	to
Sandy Clay	0'	18'
Blue Sand & Spiky Blue	18'	43'
Blue Clay	43'	265'
Water Sand	265'	217'

WELL LOCATION:
 sec. 3 T. 6 N. R. 7 E.
 3/4 miles S E of Wheeler
 (distance) (direction) (nearest town)

WELL PURPOSE: Home
 (home, irrigation, municipal, industrial)

- WELL COMPLETION DATA:
- (1) diameter (inches) 4
 - (2) total depth (feet) 217"
 - (3) static water level (feet) 70' below top of ground.
 - (4) casing (material) Bl Steel, (depth) 45'
 - (size) 1 1/2" If telescope see back.
 - (5) screen none (length) (depth to top)
 - (size) none (material)
 - (6) pump 3/4 (HP) 6 (yield gpm)
 - Jet Jet (type power)
 - (7) electric log none (yes or no)
 - none (organization running log)
 - (8) how well bottom plugged Open

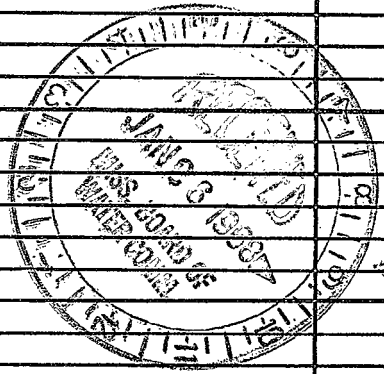

DRILLERS REMARKS:

If well telescopes please sketch and show depths.

GROUND LEVEL

X			

SECTION 4

Please indicate well location X.

ADDITIONAL INFORMATION

If more than one screen, show locations of each on sketch.