

Prentiss
 R 2003
 10-67

MISSISSIPPI
 BOARD OF WATER COMMISSIONERS
 416 North State Street
 Jackson, Mississippi 39201

WATER WELL DRILLERS LOG

Oct 14 1967 date well completed
 Bond Plumbing & Drilling firm name
 Prentiss county well located

LANDOWNER: Estlin Baren

description of formations encountered	from	to
Red Clay + Sand	0'	30"
Blue Clay	40'	240"
Water Band	240'	300"


Baldwyn Miss
 (mailing address)

WELL LOCATION:
 sec 26 T 6 N R 7 E
 S W
 4 miles NW of Marquette
 (distance) (direction) (nearest town)

WELL PURPOSE: Home
 (home, irrigation, municipal, industrial)

WELL COMPLETION DATA:

- (1) diameter (inches) 4"
- (2) total depth (feet) 300"
- (3) static water level (feet) 120' below top of ground.
- (4) casing (material) 4 1/2" (depth)
- 4" (size) if telescope see back.
- (5) screen (length) (depth to top) none
- (size) (material) none
- (6) pump (HP) 1/2 (yield gpm) 42
- Elect Jet (type power)
- (7) electric log (yes or no) none
- (organization running log) none
- (8) how well bottom plugged open

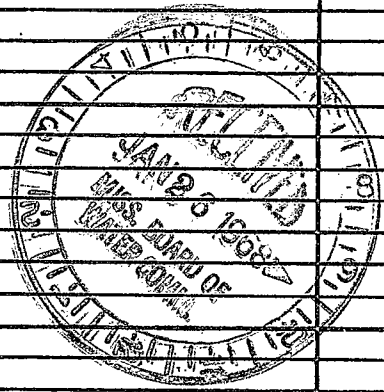

DRILLERS REMARKS:

If well telescopes please sketch and show depths.

GROUND LEVEL

			X

SECTION 26

Please indicate well location X.

ADDITIONAL INFORMATION

If more than one screen, show locations of each on sketch.