

Orestiss  
K 2004  
11-67

MISSISSIPPI  
BOARD OF WATER COMMISSIONERS  
416 North State Street  
Jackson, Mississippi 39201

WATER WELL DRILLERS LOG

Well 1967 Landdown Plumbing Orestiss  
date well completed firm name county well located

LANDOWNER: Thomas Wilson  
Zachariah Miss

description of formations encountered	from	to
<u>Sandy Clay &amp; Sand</u>	<u>0'</u>	<u>70'</u>
<u>Blue Clay</u>	<u>70'</u>	<u>195'</u>
<u>Water Band</u>	<u>195'</u>	<u>250'</u>

(mailing address)

WELL LOCATION:

sec. 8 T. 6 N. R. 7 E  
S W  
1 miles E of Zachariah  
(distance) (direction) (nearest town)

WELL PURPOSE: Home  
(home, irrigation, municipal, industrial)

WELL COMPLETION DATA:


- (1) diameter (inches) 4
- (2) total depth (feet) 250'
- (3) static water level (feet) not known below top of ground.
- (4) casing Black Steel, 72 (material), (depth)  
4" if telescope see back. (size)
- (5) screen none (length), (depth to top)  
(size), (material)
- (6) pump Self suction Pump (HP), (yield gpm)  
(type power)
- (7) electric log none (yes or no)  
(organization running log)
- (8) how well bottom plugged Open



DRILLERS REMARKS:

If well telescopes please sketch and show depths.

GROUND LEVEL

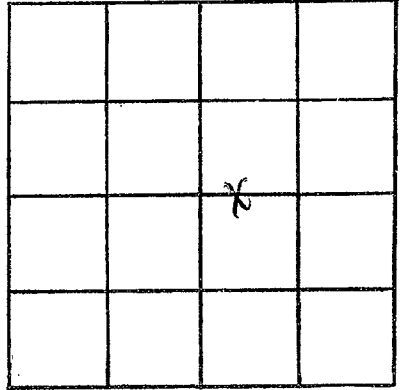

SECTION 8

Please indicate well location X.

ADDITIONAL INFORMATION

If more than one screen, show locations of each on sketch.