

**MISSISSIPPI
BOARD OF WATER COMMISSIONERS**
416 North State Street
Jackson, Mississippi 39201

WATER WELL DRILLERS LOG

PRENTISS
2005
3-68

Mar 5 1968 G.S. Bonds Plumbing & Drilling Prentiss
date well completed firm name county well located

LANDOWNER William Thomas

| description of formations encountered | from | to |
|---------------------------------------|------------|------------|
| | | |
| <u>Sandy Clay</u> | <u>0</u> | <u>35</u> |
| <u>Blue Clay</u> | <u>35</u> | <u>80</u> |
| <u>Sandy Clay</u> | <u>80</u> | <u>105</u> |
| <u>Blue Clay</u> | <u>105</u> | <u>130</u> |
| <u>Water Table</u> | <u>130</u> | <u>190</u> |


Rt 4 meadow Creek RD 7284961
Booneville Miss
(mailing address)

WELL LOCATION:
sec. 2 T. 2 N. R. 7 E
2 miles S of Booneville
(distance) (direction) (nearest town)

WELL PURPOSE:
(home, irrigation, municipal, industrial)

WELL COMPLETION DATA:


- (1) diameter (inches) 4
- (2) total depth (feet) 190
- (3) static water level (feet) 60 below above top of ground.
- (4) casing 190 12
(material) (depth)
- 40 (size) telescope see back.
- (5) screen none
(length) (depth to top)
- none
(size) (material)
- (6) pump well not drilled
(HP) (yield gpm)
- (type power)
- (7) electric log none
(yes or no)
- none
(organization running log)
- (8) how well bottom plugged Open

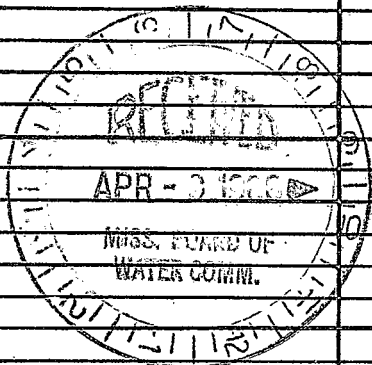

DRILLERS REMARKS:

If well telescopes please sketch and show depths.

GROUND LEVEL

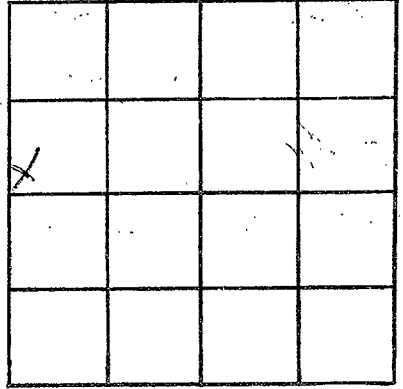

SECTION 22

Please indicate well location X.

ADDITIONAL INFORMATION

If more than one screen, show locations of each on sketch.