

Prentiss  
 152000  
 7-9-68

MISSISSIPPI  
 BOARD OF WATER COMMISSIONERS  
 416 North State Street  
 Jackson, Mississippi 39201

WATER WELL DRILLERS LOG

July 19 1968 Bonds Prentiss  
 date well completed firm name county well located


LANDOWNER: Moore Bishop  
At 2 Baldwin  
Miss  
 (mailing address)

WELL LOCATION:  
 sec. 26 T 6 N R 7 E  
4 miles E NE of Baldwin  
 (distance) (direction) (nearest town)

WELL PURPOSE: Home  
 (home, irrigation, municipal, industrial)

- WELL COMPLETION DATA:
- (1) diameter (inches) 4 280
  - (2) total depth (feet) 280
  - (3) static water level (feet) 110 below top of ground.
  - (4) casing steel 125 6"  
 (material) (depth)  
4" if telescope see back.  
 (size)
  - (5) screen none  
 (length) (depth to top)  
none  
 (size) (material)
  - (6) pump 1 1/2 5  
 (HP) (yield gpm)  
Calent  
 (type power)
  - (7) electric log no  
 (yes or no)  
none  
 (organization running log)
  - (8) how well bottom plugged open


description of formations encountered	from	to
Red Clay	0	3
Sandy clay	3	24
1" Blue clay	24	90
Sand + Blue in streaks	90	122
Blue clay	122	210
Water level	210	280

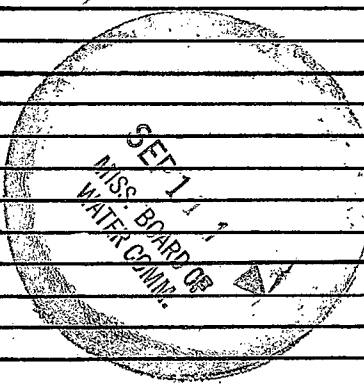

DRILLERS REMARKS:

If well telescopes please sketch and show depths.

GROUND LEVEL

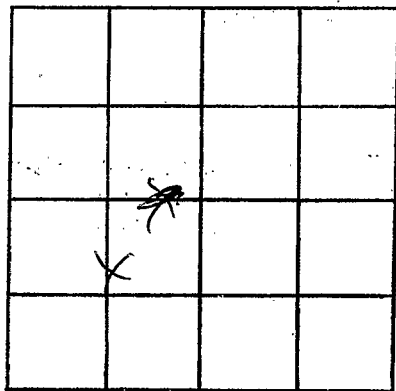

SECTION 26

Please indicate well location X.

ADDITIONAL INFORMATION

If more than one screen,  
show locations of each on sketch.