

PRENTISS

K 2007

12-11-75

MISSISSIPPI BOARD OF WATER COMMISSIONERS  
416 North State Street  
Jackson, Mississippi 39201

WATER WELL DRILLERS LOG

12-11 1975 Bonds Well Drilling Prentiss  
date well completed firm name county well located


LANDOWNER: <u>Jesse Hoard</u> <u>Bonerville</u>	description of formations encountered	from	to
(mailing address)	Red Clay	0	20
WELL LOCATION:	Yellow Sand	20	35
sec. <u>10</u> T. <u>6</u> N R. <u>7</u> E	Blue Clay	35	200
<u>6</u> miles <u>SE</u> of <u>Bonerville</u> (distance) (direction) (nearest town)	Water Sand	200	235
WELL PURPOSE: <u>Home</u> (home, irrigation, municipal, industrial)			
WELL COMPLETION DATA:			
(1) diameter (inches) <u>4"</u>			
(2) total depth (feet) <u>235'</u>			
(3) static water level (feet) <u>180</u> <u>below</u> above top of ground.			
(4) casing <u>Plastic</u> , <u>40</u> (material) (depth)			
_____ If telescope see back. (size)			
(5) screen <u>no</u> (length) (depth to top)			
_____ (size) _____ (material)			
(6) pump <u>1 1/2</u> <u>5gpm</u> (HP) (yield gpm)			
<u>elect.</u> (type power)			
(7) electric log <u>no</u> (yes or no)			
_____ (organization running log)			
(8) how well bottom plugged <u>open</u>			
DRILLERS REMARKS:			

RECEIVED  
DEC 7 1978

MISS. BD. OF WATER COMMISSIONERS

If well telescopes please sketch and show depths.

GROUND LEVEL

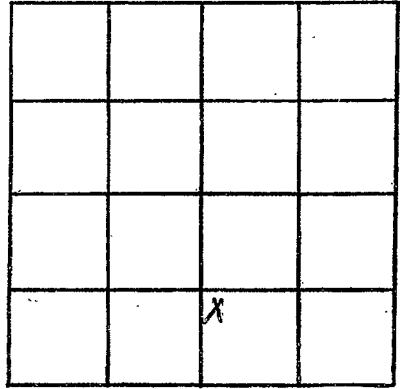

SECTION \_\_\_\_\_

Please indicate well location X.

ADDITIONAL INFORMATION

If more than one screen,  
show locations of each on sketch.