

**MISSISSIPPI
BOARD OF WATER COMMISSIONERS**
416 North State Street
Jackson, Mississippi 39201

WATER WELL DRILLERS LOG


Herman Homan Well & Supply, Inc.
P. O. Box 42
SHANNON, MISSISSIPPI 38868

Prentiss
~~Prentiss~~
county well located

Prentiss
R 2008
9-22-75

9/22 19 *75*
date well completed

LANDOWNER:	description of formations encountered	from	to
<i>Charles Bonds</i> <i>P.O. 3, Baldessa, Miss</i> (mailing address)	<i>Smear sand</i>		<i>18</i>
	<i>clay</i>	<i>0</i>	<i>18</i>
	<i>Blue clay</i>	<i>18</i>	<i>140</i>
	<i>Sand</i>	<i>140</i>	<i>260</i>
	<i>Bottom</i>	<i>260</i>	
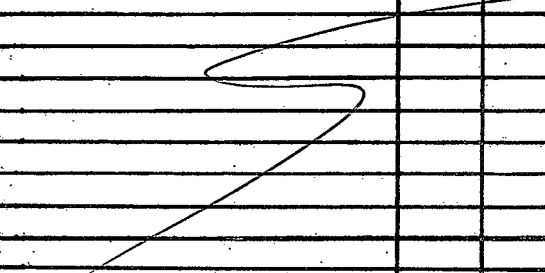
<p>WELL LOCATION: <i>136</i></p> <p>sec <i>13</i> T <i>7</i> N R <i>7</i> E S W</p> <p><i>3 1/2</i> miles SW of <i>Sumner</i> (distance) (direction) (nearest town)</p>	
---	--

WELL PURPOSE: *Home*
(home, irrigation, municipal, industrial)

WELL COMPLETION DATA:

(1) diameter (inches) *4*

(2) total depth (feet) *260*

(3) static water level (feet) *80* below above top of ground.

(4) casing *Steel*, *21*
(material) (depth)
4" If telescope see back.
(size)

(5) screen *NO*, (depth to top)
(length) (material)

(6) pump *NO*, (yield gpm)
(HP) (type power)

(7) electric log *NO*
(yes or no)
(organization running log)

(8) how well bottom plugged *Open*


RECEIVED
BOARD OF WATER COMMISSIONERS
JACKSON, MISSISSIPPI
SEP 23 1975

DRILLERS REMARKS:

MISS. BD. OF WATER COMMISSIONERS

If well telescopes please sketch and show depths.

GROUND LEVEL

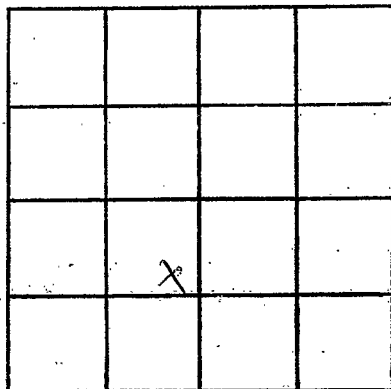

SECTION 13

Please indicate well location X.

ADDITIONAL INFORMATION

If more than one screen,
show locations of each on sketch.