

Prentiss  
K 2009  
11-10-75

MISSISSIPPI  
BOARD OF WATER COMMISSIONERS  
416 North State Street  
Jackson, Mississippi 39201

WATER WELL DRILLERS LOG

11-10 1975 date well completed  
Herman Homan Well & Supply, Inc.  
P.O. Box 42  
firm name  
SHANNON, MISSISSIPPI 38868  
Prentiss county well located

LANDOWNER:  
Arthur Pace  
P.O. 3, BA Dawson Miss  
(mailing address)

description of formations encountered	from	to
surface sand & clay	0	18
Blue clay	18	140
Sand	140	260
Siltstone	260	

WELL LOCATION:  
sec. 12 T. 9N R. 8E  
S W  
3 miles SW of Maudette  
(distance) (direction) (nearest town)

WELL PURPOSE: Home  
(home, irrigation, municipal, industrial)


- WELL COMPLETION DATA:
- (1) diameter (inches) 4"
  - (2) total depth (feet) 260'
  - (3) static water level (feet) 65' below top of ground
  - (4) casing (material) steel (depth) 24'
  - 4" if telescope see back. (size)
  - (5) screen 1/2" (length) (depth to top)
  - (size) (material)
  - (6) pump NO (HP) (yield gpm)
  - (type power)
  - (7) electric log NO (yes or no)
  - (organization running log)
  - (8) how well bottom plugged open

DRILLERS REMARKS:

RECEIVED  
DEC 15 1975  
MISS. BD. OF WATER COMM.

If well telescopes please sketch and show depths.

GROUND LEVEL

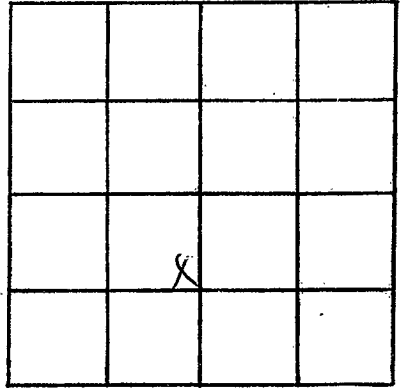

SECTION 12

Please indicate well location X.

ADDITIONAL INFORMATION

If more than one screen, show locations of each on sketch.