

PRENTISS
 R. 2011
 1-30-76

MISSISSIPPI
 BOARD OF WATER COMMISSIONERS
 416 North State Street
 Jackson, Mississippi 39201

138

WATER WELL DRILLERS LOG

1-30 1976 J. W. Wilkerson Prentiss
 date well completed firm name county well located

LANDOWNER Billy Joe H. Lawrence

description of formations encountered	from	to
Soil	0	1
Sand & Clay	1	49
Very Hard Rock	49	51
Clay & Sand	51	63
Blue Rock	63	190
Water Sand	190	300

Baldwyn, Miss
 (mailing address)

WELL LOCATION:
 sec 34 T 34 N R 7 E
460 W
5 miles East of Baldwyn
 (distance) (direction) (nearest town)

WELL PURPOSE:
 (home, irrigation, municipal, industrial)

- WELL COMPLETION DATA:
- (1) diameter (inches) 5
 - (2) total depth (feet) 300
 - (3) static water level (feet) 73 below above top of ground.
 - (4) casing Steel, 169ft
 (material) (depth)
 _____ if telescope see back.
 (size)
 - (5) screen 0 / 0
 (length) (depth to top)
0 / 0
 (size) (material)
 - (6) pump Windsor 20
 (HP) (yield gpm)
Electric
 (type power)
 - (7) electric log no
 (yes or no)

 (organization running log)
 - (8) how well bottom plugged _____


RECEIVED
 MAR 4 1976

DRILLERS REMARKS:

MISSISSIPPI WATER BOARD

If well telescopes please sketch and show depths.

GROUND LEVEL

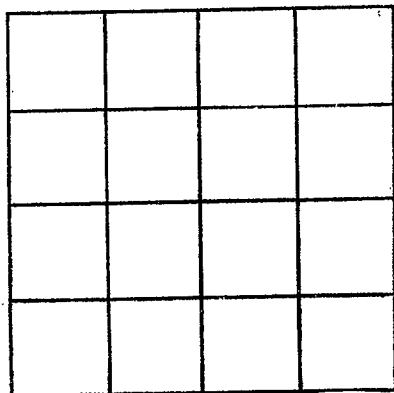

SECTION _____

Please indicate well location X.

ADDITIONAL INFORMATION

If more than one screen,
show locations of each on sketch.