

PRENTISS
K 2013
9-2-76

**MISSISSIPPI
BOARD OF WATER COMMISSIONERS**
416 North State Street
Jackson, Mississippi 39201

WATER WELL DRILLERS LOG

9-2 1976 Bonds Well Drilling Prentiss
 date well completed firm name county well located

LANDOWNER: <u>James Watson</u> <u>Baldwyn</u> (mailing address)	description of formations encountered	from	to
		<u>Red Clay</u>	0
	<u>Yellow Sand</u>	20	30
	<u>Blue Clay</u>	30	240
	<u>Water Sand</u>	240	300

WELL LOCATION:
 sec. 32 T. 6 N. R. 7 W.
6 miles E of Baldwyn
 (distance) (direction) (nearest town)

WELL PURPOSE: Home
 (home, irrigation, municipal, industrial)

WELL COMPLETION DATA:

(1) diameter (inches) 4"

(2) total depth (feet) 300'

(3) static water level (feet) 50 below above top of ground.

(4) casing Plastic, 42'
 (material) (depth)
 (size) If telescope see back.

(5) screen no
 (length) (depth to top)
 (size) (material)

(6) pump 3/4 10 gpm
 (HP) (yield gpm)
elect.
 (type power)

(7) electric log no
 (yes or no)
 (organization running log)

(8) how well bottom plugged open


DRILLERS REMARKS:

RECEIVED
 DEC-7-1978

MISS. BD. OF WATER COMM

If well telescopes please sketch and show depths.

GROUND LEVEL

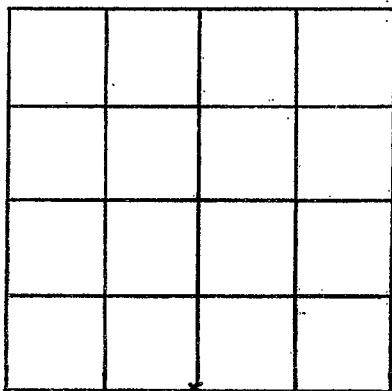

SECTION _____

Please indicate well location X.

ADDITIONAL INFORMATION

If more than one screen,
show locations of each on sketch.