

Prentiss  
K 2015  
6-24-76

MISSISSIPPI  
BOARD OF WATER COMMISSIONERS  
416 North State Street  
Jackson, Mississippi 39201

WATER WELL DRILLERS LOG

6-24 1976  
date well completed

J. W. Wilkerson  
firm name

Prentiss  
county well located

LANDOWNER: Pleasant Ridge  
Booktest Church  
Baldwyn  
(mailing/address)

description of formations encountered	from	to
Soil	0	1
Red Sand & Clay	1	30
Sand & Rock & Clay	30	115
Blue Rock	115	285
Sand	285	400
Wet Sand		

WELL LOCATION:  
sec. 20 T 6 N R 7 E  
3 miles N-East of Baldwyn  
(distance) (direction) (nearest town)

WELL PURPOSE:  
(home, irrigation, municipal, industrial)


- WELL COMPLETION DATA:
- (1) diameter (inches) 4"
  - (2) total depth (feet) 400
  - (3) static water level (feet) 98 below top of ground.
  - (4) casing steel 12.8 ft (material) (depth)  
4" (size) if telescope see back.
  - (5) screen 0 (length) 0 (depth to top)  
(size) (material)
  - (6) pump 1-1/2 HP 5 (HP) (yield gpm)  
Elee (type power)
  - (7) electric log (yes or no)  
(organization running log)
  - (8) how well bottom plugged

DRILLERS REMARKS:

RECEIVED  
JUL 20 1976  
MISS. BD. OF WATER COM.

If well telescopes please sketch and show depths.

GROUND LEVEL

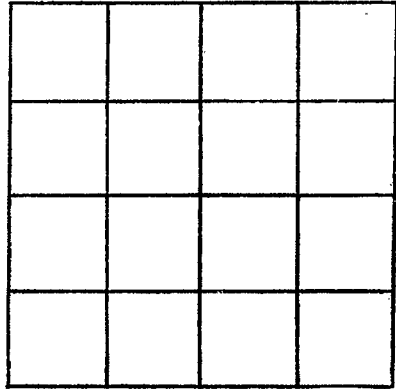

SECTION \_\_\_\_\_

Please indicate well location X.

ADDITIONAL INFORMATION

If more than one screen, show locations of each on sketch.