

Prentiss
R 2016
4-1-77

MISSISSIPPI
 BOARD OF WATER COMMISSIONERS
 416 North State Street
 Jackson, Mississippi 39201

13B

WATER WELL DRILLERS LOG

4-1-77 1977 Herman Homan Well & Supply, Inc. Prentiss
 date well completed firm Box 42 county well located
 SHANNON, MISSISSIPPI 38662

LANDOWNER:	description of formations encountered	from	to
<u>L. C. Cagle Sr.</u>	<u>surface sand</u>	<u>0</u>	<u>36</u>
<u>Box 4 Bookville, MS.</u> (mailing address)	<u>clay</u>	<u>36</u>	<u>201</u>
	<u>blue clay</u>	<u>201</u>	<u>340</u>
	<u>sand</u>	<u>340</u>	<u>340</u>
	<u>Bottom</u>	<u>340</u>	

WELL LOCATION:
 sec. 24 T. 6 N. R. 7 E.
 S. W.
4 1/2 miles NW of MARICHA
 (distance) (direction) (nearest town)

WELL PURPOSE: Home
 (home, irrigation, municipal, industrial)

- WELL COMPLETION DATA:
- (1) diameter (inches) 4"
 - (2) total depth (feet) 340'
 - (3) static water level (feet) 145' below above top of ground
 - (4) casing steel 42'
 (material) (depth)
4" If telescope see back.
 (size)
 - (5) screen AD
 (length) (depth to top)
 (size) (material)
 - (6) pump 1/2 5
 (HP) (yield gpm)
electric
 (type power)
 - (7) electric log NO
 (yes or no)
 (organization running log)
 - (8) how well bottom plugged Open


DRILLERS REMARKS:

RECEIVED
 MAY 2 - 1977

MISS. Bd. OF WATER COMM.

If well telescopes please sketch and show depths.

GROUND LEVEL

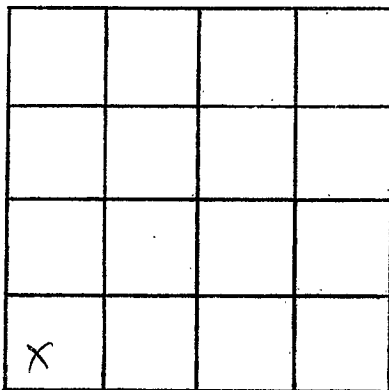

SECTION 24

Please indicate well location X.

ADDITIONAL INFORMATION

If more than one screen, show locations of each on sketch.