

PRENTISS  
 2017<sup>K</sup>  
 9-22-77.

MISSISSIPPI  
 BOARD OF WATER COMMISSIONERS  
 416 North State Street  
 Jackson, Mississippi 39201

WATER WELL DRILLERS LOG

9-2 1977 Bonds Well Drilling Prentiss  
 date well completed firm name county well located

LANDOWNER: <u>Ray Morgan</u>	description of formations encountered	from	to
<u>Boonville</u>			
	<u>Red Clay</u>	<u>0</u>	<u>20</u>
	<u>Yellow Sand</u>	<u>20</u>	<u>50</u>
	<u>Blue Clay</u>	<u>50</u>	<u>300</u>
(mailing address)	<u>Water Sand</u>	<u>300</u>	<u>360</u>

WELL LOCATION:  
 sec. 35 T 6 N R 7 E  
6 miles E of Baldwyn  
 (distance) (direction) (nearest town)

WELL PURPOSE: Home  
 (home, irrigation, municipal, industrial)

WELL COMPLETION DATA:

(1) diameter (inches) 4"

(2) total depth (feet) 360

(3) static water level (feet) 160 below above top of ground.

(4) casing Plastic, 60  
 (material) (depth)  
 (size) If telescope see back.

(5) screen no  
 (length) (depth to top)  
 (size) (material)

(6) pump none  
 (HP) (yield gpm)  
 (type power)

(7) electric log no  
 (yes or no)  
 (organization running log)


(8) how well bottom plugged open

DRILLERS REMARKS:

RECEIVED  
 DEC - 5 1977

If well telescopes please sketch and show depths.

GROUND LEVEL

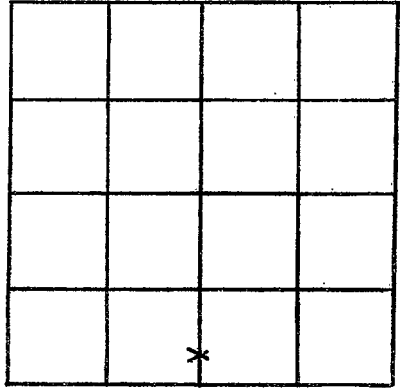

SECTION \_\_\_\_\_

Please indicate well location X.

ADDITIONAL INFORMATION

If more than one screen, show locations of each on sketch.