

PRENTISS

K 2008

8-5-77

MISSISSIPPI BOARD OF WATER COMMISSIONERS 416 North State Street Jackson, Mississippi 39201

WATER WELL DRILLERS LOG

8-5 1977 Bonds Well Drilling Prentiss date well completed firm name county well located

LANDOWNER: <u>Billy Mc Vay</u>	description of formations encountered	from	to
<u>Booneville</u>			
(mailing address)	<u>Red Clay</u>	<u>0</u>	<u>20</u>
	<u>Yellow Sand</u>	<u>20</u>	<u>50</u>
	<u>Blue Clay</u>	<u>50</u>	<u>200</u>
	<u>Water Sand</u>	<u>200</u>	<u>258</u>

WELL LOCATION: sec. 1 T. 6 N R. 7 E 6 miles SE of Booneville (distance) (direction) (nearest town)

WELL PURPOSE: Home (home, irrigation, municipal, industrial)


- WELL COMPLETION DATA:
- (1) diameter (inches) 4"
 - (2) total depth (feet) 258
 - (3) static water level (feet) 80 below above top of ground.
 - (4) casing Plastic, 60 (material) (depth) (size) If telescope see back.
 - (5) screen no (length) (depth to top) (size) (material)
 - (6) pump 2 5 gpm (HP) (yield gpm) elect (type power)
 - (7) electric log no (yes or no) (organization running log)
 - (8) how well bottom plugged open

DRILLERS REMARKS:

RECEIVED DEC - 5 1978

If well telescopes please sketch and show depths.

GROUND LEVEL

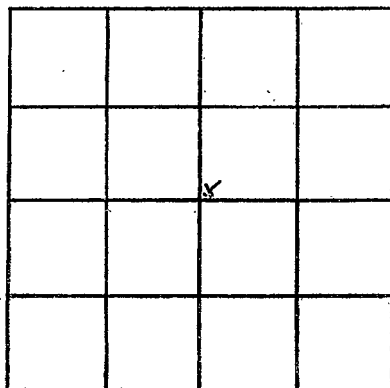

SECTION _____

Please indicate well location X.

ADDITIONAL INFORMATION

If more than one screen, show locations of each on sketch.