

PRENTISS
K 209
5-25-77

MISSISSIPPI
BOARD OF WATER COMMISSIONERS
416 North State Street
13B Jackson, Mississippi 39201

WATER WELL DRILLERS LOG

Herman Homan Well & Supply, Inc.

Prentiss

5-15 1977
date well completed

SHANNON MISSISSIPPI 38168

county well located

LANDOWNER:

Casey Creek Baptist Church
P.O. Box 42
Boonville, MS
(mailing address)

description of formations encountered

from to

surface clay 0 16
Blue clay 16 180
Sand 180 320
Bottom 320

WELL LOCATION:

sec. 35 T 6 N R 7 E
3 1/2 miles S W of Markham
(distance) (direction) (nearest town)

WELL PURPOSE: Chad
(home, irrigation, municipal, industrial)

WELL COMPLETION DATA:

- (1) diameter (inches) 4"
- (2) total depth (feet) 320'
- (3) static water level (feet) 106' below above top of ground.
- (4) casing steel, 21 1/2" (material) (depth)
4" (size) if telescope see back.
- (5) screen 1/2" (length) (depth to top)
(size) (material)
- (6) pump 1/2 (HP) 5 (yield gpm)
electric (type power)
- (7) electric log no (yes or no)

(organization running log)

(8) how well bottom plugged open

DRILLERS REMARKS:


RECEIVED

JUN 1 1977

MISSISSIPPI BOARD OF WATER COMMISSIONERS

If well telescopes please sketch and show depths.

GROUND LEVEL

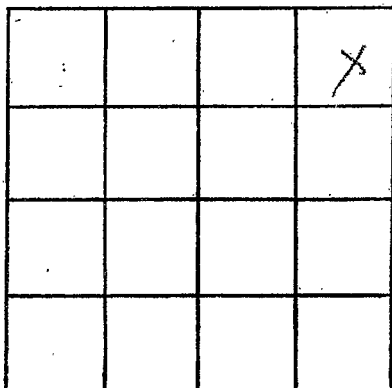

SECTION 35

Please indicate well location X.

ADDITIONAL INFORMATION

If more than one screen, show locations of each on sketch.