

PRENTISS

K 2020

9-22-77

MISSISSIPPI BOARD OF WATER COMMISSIONERS 416 North State Street Jackson, Mississippi 39201

WATER WELL DRILLERS LOG

9-22 1977 Bomb Well Drilling Prentiss date well completed firm name county well located

Table with 4 columns: LANDOWNER (Horace Holder), Booneville (Booneville), description of formations encountered (Red Clay, Yellow Sand, Blue Clay, Water Sand), from (0, 20, 60, 80), to (20, 60, 80, 130)

WELL LOCATION: sec 28 T 6 N R 7 E 3 miles N of Baldwin (distance) (direction) (nearest town)

WELL PURPOSE: Home (home, irrigation, municipal, industrial)

- WELL COMPLETION DATA: (1) diameter (inches) 4" (2) total depth (feet) 130 (3) static water level (feet) 50 below top of ground. (4) casing Plastic, 64 (material) (depth) (size) If telescope see back. (5) screen no (length) (depth to top) (size) (material) (6) pump 1 (HP) 5 gpm (type power) elect (7) electric log no (yes or no) (organization running log) (8) how well bottom plugged open


DRILLERS REMARKS:

RECEIVED DEC - 5 1978

MISS. BD. OF WATER COMMISSIONERS

If well telescopes please sketch and show depths.

GROUND LEVEL

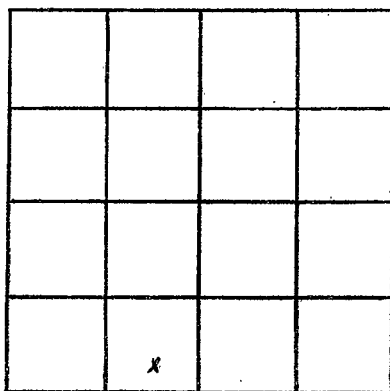

SECTION _____

Please indicate well location X.

ADDITIONAL INFORMATION

If more than one screen,
show locations of each on sketch.