

Prentiss
K 2021
11/28/77

MISSISSIPPI
BOARD OF WATER COMMISSIONERS
416 North State Street
Jackson, Mississippi 39201

WATER WELL DRILLERS LOG

Herman Homan Well & Supply, Inc.

Prentiss

11-28 1977
date well completed

P.O. Box 42
firm name
SHANNON, MISSISSIPPI 38668

county well located

LANDOWNER:
Donnie Ferowles
Attn: Baldwyn, Ms.
(mailing address)


description of formations encountered	from	to
surface sand	0	95
blue clay	55	225
sand	225	320
bottom	320	

WELL LOCATION:
sec. 35 T. 6 N. R. 7 E.
6 miles E of Baldwyn
(distance) (direction) (nearest town)

WELL PURPOSE: Home
(home, irrigation, municipal, industrial)

- WELL COMPLETION DATA:
- diameter (inches) 4"
 - total depth (feet) 320'
 - static water level (feet) 110' below top of ground
 - casing (material) Steel, (depth) 105'
 - screen (size) 4" (length) NO (depth to top)
 - pump (HP) 1/2 (material) S (yield gpm) 5
electric (type power)
 - electric log NO (yes or no)
 - organization running log
 - how well bottom plugged open

DRILLERS REMARKS:

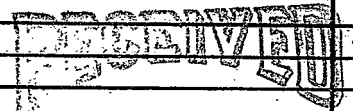


DEC 22 1977

MISS. BD. OF WATER COMMISSIONERS

If well telescopes please sketch and show depths.

GROUND LEVEL

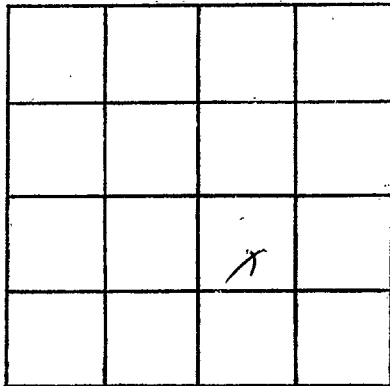

SECTION 35

Please indicate well location X.

ADDITIONAL INFORMATION

If more than one screen,
show locations of each on sketch.