

Prentiss
K 2022
12/9/77

MISSISSIPPI
BOARD OF WATER COMMISSIONERS
416 North State Street
Jackson, Mississippi 39201

WATER WELL DRILLERS LOG

Prentiss

12-5 1977 Herman Homan Well & Supply, Inc.
date well completed firm name

county well located

LANDOWNER:
Kearath Roward
Rt Baldwin, MS
(mailing address)

WELL LOCATION:
sec. 35 T. 6 N. R. 7 E
S W
6 miles E of Baldwin
(distance) (direction) (nearest town)

WELL PURPOSE: Home
(home, irrigation, municipal, industrial)

- WELL COMPLETION DATA:
- diameter (inches) 4
 - total depth (feet) 340'
 - static water level (feet) 150' below above top of ground.
 - casing steel, 21' (material) (depth)
4" (size) if telescope see back.
 - screen no (length) (depth to top)
(size) (material)
 - pump 1/2 (HP) 5 (yield gpm)
electric (type power)
 - electric log no (yes or no)
(organization running log)
 - how well bottom plugged no

DRILLERS REMARKS:

description of formations encountered	from	to
surface sand		
blue clay	0	18
sand	200	300
botte	340	


RECEIVED

DEC 22 1977

MISS. BD. OF WATER COMM.

If well telescopes please sketch and show depths.

GROUND LEVEL

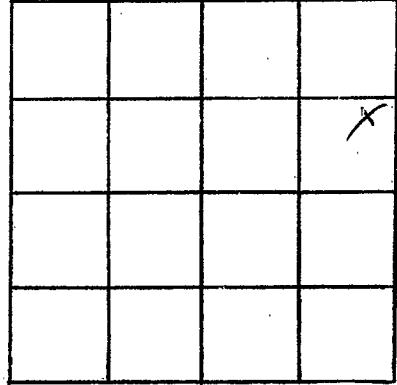

SECTION 6

Please indicate well location X.

ADDITIONAL INFORMATION

If more than one screen,
show locations of each on sketch.