

PRENTISS
 K 2023
 10-16-78

MISSISSIPPI
 BOARD OF WATER COMMISSIONERS
 416 North State Street
 Jackson, Mississippi 39201

WATER WELL DRILLERS LOG

10/16 1978 date well completed
 P. O. Box 42
 SHANNON, MISSISSIPPI 38868 firm name
 Prentiss county well located

LANDOWNER:
 Jack Foster
 care of Bradville
 (mailing address)

WELL LOCATION:
 sec. 35 T. 6 N R. 7 E
 S W
 3 miles (distance) NW of Magnolia (direction) (nearest town)

WELL PURPOSE: Home
 (home, irrigation, municipal, industrial)

WELL COMPLETION DATA:

(1) diameter (inches) 5"

(2) total depth (feet) 340'

(3) static water level (feet) 102' below top of ground.

(4) casing (material) steel (depth) 24' 3"

5" (size) if telescope see back.

(5) screen (length) (depth to top)

(size) (material)

(6) pump (HP) (yield gpm)

(type power)

(7) electric log (yes or no)

(organization running log)

(8) how well bottom plugged


description of formations encountered	from	to
surface sand	0	18'
Blue clay	18'	200'
Sand	200'	340'
Silt	340'	

RECEIVED
 NOV 6 1978
 MISS. DEPT. OF WATER COMMISSIONERS

DRILLERS REMARKS:

If well telescopes please sketch and show depths.

GROUND LEVEL

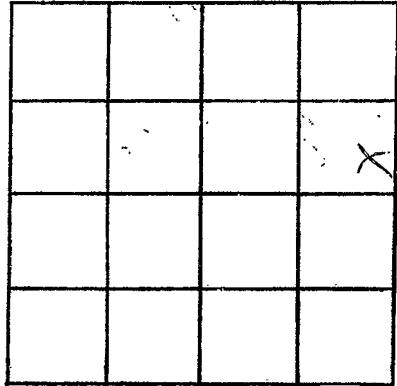

SECTION 35

Please indicate well location X.

ADDITIONAL INFORMATION

Lined area for additional information.

If more than one screen, show locations of each on sketch.