

Prentiss
K Joane
7-27-79

MISSISSIPPI
BOARD OF WATER COMMISSIONERS
416 North State Street
Jackson, Mississippi 39201

WATER WELL DRILLERS LOG

7-27-79 1979 Bonds Well Drilling Prentiss
date well completed firm name county well located

LANDOWNER: <u>Mary Ryan</u> <u>Boonville, MS</u>	description of formations encountered	from	to
(mailing address)	Red clay	0	60
WELL LOCATION:	White sand	50	90
sec. <u>34</u> T. <u>2</u> N. (R) <u>7</u> E. (S) <u>W</u> <u>10</u> miles <u>S</u> of <u>Boonville</u> (distance) (direction) (nearest town)	Blue clay	90	200
WELL PURPOSE: <u>Home</u> (home, irrigation, municipal, industrial)	Water sand	200	260
WELL COMPLETION DATA:			
(1) diameter (inches) <u>4"</u>			
(2) total depth (feet) <u>260'</u>			
(3) static water level (feet) <u>200</u> <u>below</u> above top of ground.			
(4) casing <u>4"</u> <u>96'</u> (material) (depth)			
_____ If telescope see back. (size)			
(5) screen _____ (length) (depth to top)			
_____ (size) _____ (material)			
(6) pump <u>3/4</u> <u>10</u> (HP) (yield gpm)			
_____ (type power)			
(7) electric log <u>no</u> (yes or no)			
_____ (organization running log)			
(8) how well bottom plugged <u>Open</u>			
DRILLERS REMARKS:			


DEPT. OF NATURAL RESOURCES
BUREAU OF LAND & WATER RESOURCES

AUG 21 1980

RECEIVED

If well telescopes please sketch and show depths.

GROUND LEVEL

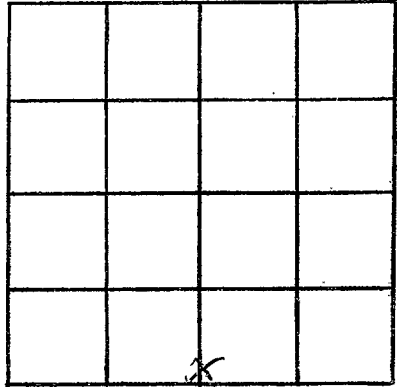

SECTION _____

Please indicate well location X.

ADDITIONAL INFORMATION

If more than one screen, show locations of each on sketch.