

CODED

MISSISSIPPI BOARD OF WATER COMMISSIONERS
416 North State Street
Jackson, Mississippi 39201

MAR 3 1972

WATER WELL DRILLERS LOG

Prentiss
L55
2-1-72

2-1 date well completed 1972 Bond Well Drilling firm name Prentiss county well located

LANDOWNER: Ruby Jackson
Brownwell Miss
(mailing address)

description of formations encountered	from	to
Red clay	0	38
Blue clay	38	64
Water sand	64	110

WELL LOCATION:
sec. 10 T. 7 N. R. 8
2 miles South of Marquette
(distance) (direction) (nearest town)

WELL PURPOSE: Home
(home, irrigation, municipal, industrial)


- WELL COMPLETION DATA:
- (1) diameter (inches) 4
 - (2) total depth (feet) 110
 - (3) static water level (feet) 32 below above top of ground.
 - (4) casing Steel, 42,
(material) (depth)
(size) if telescope see back.
 - (5) screen None
(length) (depth to top)
(size) (material)
 - (6) pump 1/2 5
(HP) (yield gpm)
Electric pump
(type power)
 - (7) electric log no
(yes or no)
(organization running log)
 - (8) how well bottom plugged Open

CODED

DRILLERS REMARKS:

If well telescopes please sketch and show depths.

GROUND LEVEL

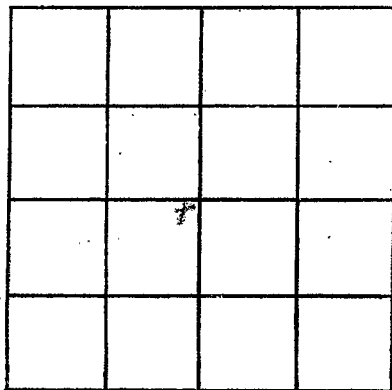

SECTION _____

Please indicate well location X.

ADDITIONAL INFORMATION

If more than one screen,
show locations of each on sketch.