

PRENTISS MISSISSIPPI BOARD OF WATER COMMISSIONERS

L56

11-20-65

WATER WELL DRILLERS LOG

CODED

Herndon-Homan Well & Supply, Inc.

P. O. Box 42

Date: Nov. 20, 1965, Driller: SHANNON, MISSISSIPPI 38688 County: Prentiss
(Name)

- (1) Owner of Land: J. B. Barnes
7284204 (Name)
Marietta, Miss
(Address)
- (2) Location: NW 1/4, SE 1/4, Sec. 17, T. 73 N., R. 21 E.
2 1/2 miles S, of Marietta,
(distance) (direction) (Nearest Town)
- (3) Topography: Hilly
(Hilly) (Flat) (Level)
- (4) Purpose of Well: Domestic
(Domestic Irrigation, Municipal, Industrial, Other)

Description & Color of Materials Sand, Clay, Red Clay, Shell, etc.	Thick- ness Feet	Depth Feet
<u>sand + clay</u>		<u>0-14</u>
<u>blue clay</u>		<u>14-20</u>
<u>sand</u>		<u>20-140</u>
<u>Gravel</u>		<u>140</u>

Information upon completion of well:


- (1) Diameter 4 inches.
- (2) Total Depth 140 feet.
- (3) Water Level 30 feet below top of ground.
- (4) Cased to 16', Size 4 1/2.
- (5) Screen: Size —, Length —.
- (6) Were any formations sealed against pollution?
 yes, no.

If YES depth of formation 14'

Why surface sand

Drillers Remarks:

CODED

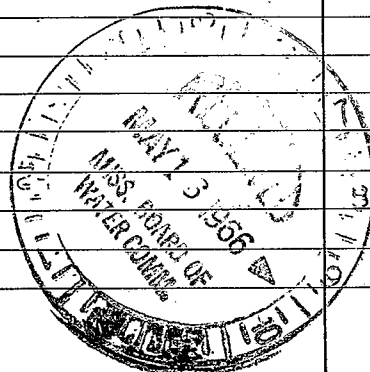

(Use Back Side)

Well No.

