

L58

4-30-62

WATER WELL DRILLERS LOG

CODED

Date: April 30, 1962, Driller: HERNDON WELL & SUPPLY Co. Prentiss

P.O. BOX 42 SHANNON, MISSISSIPPI

	Description & Color of Materials Sand, Clay, Red Clay, Shell, etc.	Thick- ness Feet	Depth Feet
(1) Owner of Land: James W. Harris (Name) 7286951 (Address) Madison, Mississippi	surface sand & clay		0
(2) Location: SE 1/4, NW 1/4, Sec. 4 T. 73 N. R. 10 E 1 miles (distance), N (direction), of Madison (Nearest Town)	Blue earth	110	120
(3) Topography: flat (Hilly) (Flat) (Level)	sand		220
(4) Purpose of Well: Domestic (Domestic Irrigation Municipal, Industrial, Other)	Bottom		

Information upon completion of well:


- (1) Diameter 4 inches.
- (2) Total Depth 220 feet.
- (3) Water Level 50 feet below top of ground.
- (4) Cased to 114', Size 44
- (5) Screen: Size _____, Length _____
- (6) Were any formations sealed against pollution?
yes, no.

If YES depth of formation 10 ft.

Why surface & sand

Drillers Remarks:

CODED

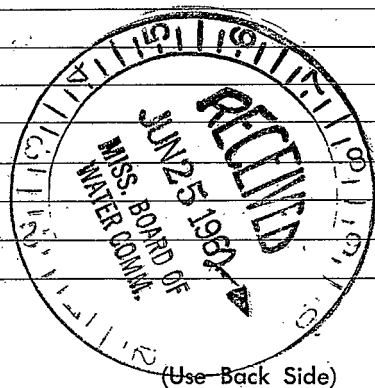

Well No.

