

PRENTISS
L 59
3-14-73

MISSISSIPPI
BOARD OF WATER COMMISSIONERS
 416 North State Street
 Jackson, Mississippi 39201

CODED

WATER WELL DRILLERS LOG

3-14 1973 Bonds Well Drilling Prentiss
 date well completed firm name county well located

LANDOWNER: Little Creek Baptist Church
Bronerville, Ms.
 (mailing address)

description of formations encountered	from	to
<u>Red Clay</u>	<u>0</u>	<u>36</u>
<u>Blue Clay</u>	<u>36</u>	<u>86</u>
<u>Water Sand</u>	<u>86</u>	<u>130</u>

WELL LOCATION:
 sec. 20 T. 6 N. R. 8 E.
12 miles SE of Bronerville
 (distance) (direction) (nearest town)

WELL PURPOSE: church
 (home, irrigation, municipal, industrial)

- WELL COMPLETION DATA:
- diameter (inches) 4
 - total depth (feet) 130
 - static water level (feet) 10 below above top of ground.
 - casing steel, 49,
 (material) (depth)
 (size) if telescope see back.
 - screen None,
 (length) (depth to top)
 (size) (material)
 - pump 3/4, 6
 (HP) (yield gpm)
Elec.
 (type power)
 - electric log no
 (yes or no)
 (organization running log)
 - how well bottom plugged open


CODED

DRILLERS REMARKS:

MAY 2 1973

If well telescopes please sketch and show depths.

GROUND LEVEL

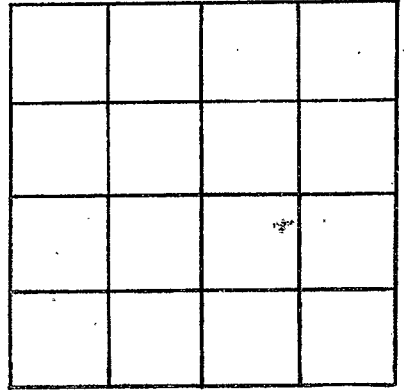

SECTION _____

Please indicate well location X.

ADDITIONAL INFORMATION

If more than one screen,
show locations of each on sketch.