

**MISSISSIPPI
BOARD OF WATER COMMISSIONERS**
416 North State Street
Jackson, Mississippi 39201

CODED

WATER WELL DRILLERS LOG

Prentiss.
L 60
2-69

2-12 date well completed 169 Bonds Well Drilling firm name Prentiss county well located

LANDOWNER: Gene Brudlowe
R. 4
Bronville
(mailing address)

description of formations encountered	from	to
<u>Yellow Sand</u>	<u>0</u>	<u>28</u>
<u>blue clay</u>	<u>28</u>	<u>150</u>
<u>Water Sand</u>	<u>150</u>	<u>200</u>

WELL LOCATION:
sec. 7 T. 6^S R. 8^E
8 1/2 miles South-East of Bronville
(distance) (direction) (nearest town)

WELL PURPOSE: Home
(home, irrigation, municipal, industrial)

WELL COMPLETION DATA:

(1) diameter (inches) 4

(2) total depth (feet) 200

(3) static water level (feet) _____ below/above top of ground.

(4) casing Steel 32
(material) (depth)
_____ if telescope see back.
(size)

(5) screen none
(length) (depth to top)
_____ (size) _____ (material)

(6) pump _____ (HP) _____ (yield gpm)
_____ (type power)

(7) electric log no
(yes or no)
_____ (organization running log)

(8) how well bottom plugged open

CODED


MAR 10 1969

DRILLERS REMARKS:

MISS. DR. OR.
QUALITY CONTROL
REGISTERED CONTRACTOR

If well telescopes please sketch and show depths.

GROUND LEVEL

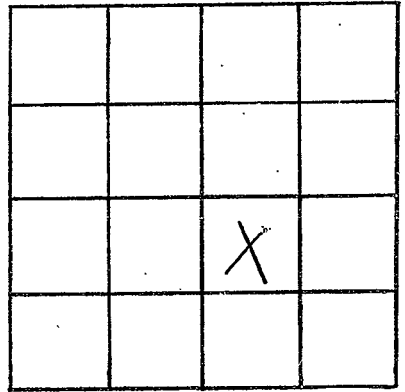

SECTION _____

Please indicate well location X.

ADDITIONAL INFORMATION

If more than one screen,
show locations of each on sketch.