

Prentiss.

L 61

2-69

MISSISSIPPI  
 BOARD OF WATER COMMISSIONERS  
 416 North State Street  
 Jackson, Mississippi 39201

CODED

WATER WELL DRILLERS LOG

2-13

1969 Bond Well Drilling

Prentiss

date well completed

firm name

county well located

LANDOWNER: Rachel Hoffmann

description of formations encountered

from

to

R. 4

Boonerville Miss  
(mailing address)

Red Clay

0 20

Yellow Sand

20 38

Blue Clay

38 150

Water Sand

150 210

WELL LOCATION:

sec. 7 T. 6<sup>S</sup> R. 8<sup>E</sup>

8 miles South-East of Boonerville  
(distance) (direction) (nearest town)

WELL PURPOSE: Home  
(home, irrigation, municipal, industrial)

CODED

WELL COMPLETION DATA:

- (1) diameter (inches) 4
- (2) total depth (feet) 210
- (3) static water level (feet) \_\_\_\_\_ below above top of ground.
- (4) casing steel 42  
(material) (depth)  
\_\_\_\_\_ if telescope see back.  
(size)
- (5) screen none  
(length) (depth to top)  
\_\_\_\_\_ (size) \_\_\_\_\_ (material)
- (6) pump \_\_\_\_\_ (HP) \_\_\_\_\_ (yield gpm)  
\_\_\_\_\_ (type power)
- (7) electric log no  
(yes or no)  
\_\_\_\_\_ (organization running log)
- (8) how well bottom plugged open


DRILLERS REMARKS:

MAR 10 1969

MISS. BD. OF  
WATER COMMISSIONERS

If well telescopes please sketch and show depths.

GROUND LEVEL

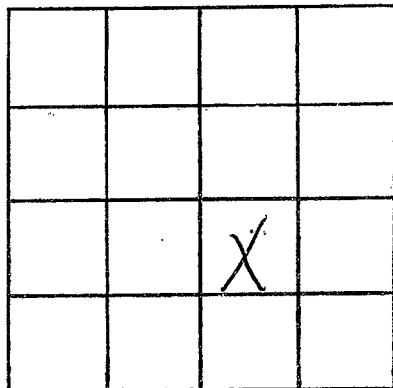

SECTION \_\_\_\_\_

Please indicate well location X.

ADDITIONAL INFORMATION

If more than one screen,  
show locations of each on sketch.