

*Prentiss*  
 L 62  
 3-21-69

MISSISSIPPI  
 BOARD OF WATER COMMISSIONERS  
 416 North State Street  
 Jackson, Mississippi 39201

**CODED**

**WATER WELL DRILLERS LOG**

March 21 1969 J. W. Well & Sons *Prentiss*  
 date well completed firm name county well located  
 1st Left Page Man. 4th hood Lt.

LANDOWNER: FELIX ROBINSON  
 Gene  
 Manetta Miss.  
 (mailing address)  
 WELL LOCATION:  
 32<sup>nd</sup> T 10<sup>th</sup> N S R 8<sup>th</sup> E  
 2 miles W of Manetta  
 (distance) (direction) (nearest town)

description of formations encountered	from	to
Clay	0	15
Clay & sand	15	30'
sand & blue marl	30	50'
Blue marl	50	70'
Water sand	70	185
Blue marl & sand	185	200

WELL PURPOSE: home  
 (home, irrigation, municipal, industrial)

WELL COMPLETION DATA:  
 (1) diameter (inches) 5"  
 (2) total depth (feet) 200  
 (3) static water level (feet) 60 below top of ground.  
 (4) casing steel 63' (material) (depth)  
 (size) If telescope see back.  
 (5) screen none (length) (depth to top)  
 (size) (material)  
 (6) pump 1 18 (HP) (yield gpm)  
 electric (type power)  
 (7) electric log no (yes or no)  
 (organization running log)  
 (8) how well bottom plugged

**CODED**


APR 1 1969

DRILLERS REMARKS:

MISS. BD. OF WATER COM.

If well telescopes please  
sketch and show depths.

GROUND LEVEL

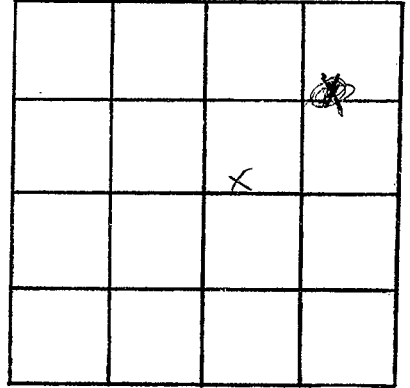

SECTION Q 32

Please indicate well location X.

ADDITIONAL INFORMATION

If more than one screen,  
show locations of each on sketch.