

**CODED**

PRENTISS  
L 63  
8-27-69

MISSISSIPPI  
BOARD OF WATER COMMISSIONERS  
416 North State Street  
Jackson, Mississippi 39201

WATER WELL DRILLERS LOG

8-27 1969 Bowch Well Drilling Prentiss  
date well completed firm name county well located  
21st Gr. RD TO LT. 472 hd

LANDOWNER: J.C. Barber  
7286175

description of formations encountered	from	to
<u>med sand</u>	<u>0</u>	<u>78</u>
<u>sandy blue</u>	<u>78</u>	<u>120</u>
<u>Water sand</u>	<u>120</u>	<u>160</u>

Boonville  
(mailing address)

WELL LOCATION:  
29 sec 6 T 6 N R 8 E  
2 miles North of Marion  
(distance) (direction) (nearest town)

WELL PURPOSE: Home  
(home, irrigation, municipal, industrial)

WELL COMPLETION DATA:

- (1) diameter (inches) 4
- (2) total depth (feet) 160
- (3) static water level (feet) 33 below above top of ground.
- (4) casing Steel, 84,  
(material) (depth)  
(size) if telescope see back.
- (5) screen None  
(length) (depth to top)  
(size) (material)
- (6) pump Hand on pump  
(HP) (yield gpm)  
(type power)
- (7) electric log No  
(yes or no)  
(organization running log)
- (8) how well bottom plugged open


**CODED**

DRILLERS REMARKS:

MISS. Bd. of  
WATER COM. 1969

If well telescopes please sketch and show depths.

GROUND LEVEL

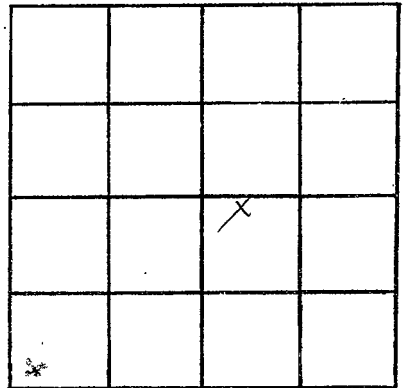

SECTION 29

Please indicate well location X.

ADDITIONAL INFORMATION

If more than one screen,  
show locations of each on sketch.