

Prentiss
L 67
5-6-70
3

MISSISSIPPI
BOARD OF WATER COMMISSIONERS
416 North State Street
Jackson, Mississippi 39201

DB WATER WELL DRILLERS LOG


5-6 1970 Bond Well Drilling Prentiss
date well completed firm name county well located

LANDOWNER: <u>Mr. Joseph Chica</u>	description of formations encountered	from	to
<u>Brownville Miss</u> (mailing address)	<u>Red clay</u> <u>Blue clay</u> <u>Water sand</u>	<u>13</u> <u>38</u> <u>198</u>	<u>38</u> <u>198</u> <u>240</u>
WELL LOCATION:			
sec. <u>6</u> T. <u>6</u> N. R. <u>8</u> E. <u>171</u> <u>6</u> miles <u>East</u> of <u>Brownville</u> (distance) (direction) (nearest town)			
WELL PURPOSE: <u>Church</u> (home, irrigation, municipal, industrial)			
WELL COMPLETION DATA:			
(1) diameter (inches) <u>4</u>			
(2) total depth (feet) <u>240</u>			
(3) static water level (feet) <u>102</u> below/above top of ground.			
(4) casing <u>Steel</u> <u>42</u> (material) (depth)			
_____ if telescope see back. (size)			
(5) screen <u>None</u> (length) (depth to top)			
_____ (size) _____ (material)			
(6) pump _____ (HP) _____ (yield gpm) <u>Hand on pump</u> (type power)			
(7) electric log <u>no</u> (yes or no)			
_____ (organization running log)			
(8) how well bottom plugged <u>open</u>			
DRILLERS REMARKS:			

JUN 9 1970

If well telescopes please sketch and show depths.

GROUND LEVEL

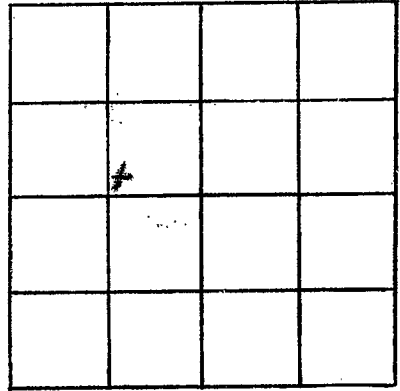

SECTION _____

Please indicate well location X.

ADDITIONAL INFORMATION

If more than one screen, show locations of each on sketch.