

Prentiss
L 68
5-18-70

MISSISSIPPI
BOARD OF WATER COMMISSIONERS
416 North State Street
Jackson, Mississippi 39201

3 DB WATER WELL DRILLERS LOG


5-18 1970 Bonds Well Drilling Prentiss
date well completed firm name county well located

LANDOWNER: Wade Wilson	description of formations encountered	from	to
Bromwich (mailing address)	Red Clay Plains & Clay Water sand	0 16 82	110 82 120
<p>WELL LOCATION:</p> <p>sec. 20 T. 6 N R. 8 E 171 8 miles S.E. of Bromwich (distance) (direction) (nearest town)</p>			
<p>WELL PURPOSE: Home (home, irrigation, municipal, industrial)</p>			
<p>WELL COMPLETION DATA:</p>			
<p>(1) diameter (inches) 4</p>			
<p>(2) total depth (feet) 120</p>			
<p>(3) static water level (feet) 30 below top of ground.</p>			
<p>(4) casing steel, 21 (material), (depth)</p>			
<p>(size) If telescope see back.</p>			
<p>(5) screen iron (length) (depth to top)</p>			
<p>(size) (material)</p>			
<p>(6) pump (HP) (yield gpm) Hand on pump (type power)</p>			
<p>(7) electric log no (yes or no)</p>			
<p>(organization running log)</p>			
<p>(8) how well bottom plugged Open</p>			
<p>DRILLERS REMARKS:</p>			

JUN 8 1970

If well telescopes please sketch and show depths.

GROUND LEVEL

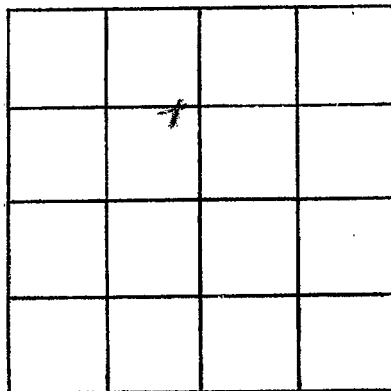

SECTION _____

Please indicate well location X.

ADDITIONAL INFORMATION

If more than one screen,
show locations of each on sketch.