

Prentiss
 L 70
 6-69

CODED

WATER WELL DRILLERS LOG

Date: 6-13, 1966, Driller: O. C. Webb, Jr., County Prentiss
 (Name)

(1) Owner of Land: Marietta
 (Name)
Water District
 (Address)

(2) Location: 1/4, 1/4, Sec. 4 T⁵R⁸E
10 miles SE of Boonville
 (distance) (direction) (Nearest Town)

(3) Topography: Hilly
 (Hilly) (Flat) (Level)

(4) Purpose of Well: Test
 (Domestic Irrigation
 Municipal, Industrial, Other)

Description & Color of Materials Sand, Clay, Red Clay, Shell, etc.	Thick- ness Feet	Depth Feet
<u>Brown Clay</u>	<u>0</u>	<u>20</u>
<u>Blue Marl Sand</u>	<u>20</u>	<u>50</u>
<u>Brown Sand</u>	<u>50</u>	<u>70</u>
<u>Blue Sand</u>	<u>70</u>	<u>200</u>
<u>Blue Marl</u>	<u>200</u>	<u>207</u>

CODED

Information upon completion of well:

(1) Diameter 4 inches.

(2) Total Depth 207 feet.

(3) Water Level 55 feet below top of ground.


(4) Cased to 63', Size 4"

(5) Screen: Size _____, Length _____.

(6) Were any formations sealed against pollution?
 _____ yes, _____ no.

If YES depth of formation _____
 Why _____

Drillers Remarks: Traces of light gravel from 940' to 170'

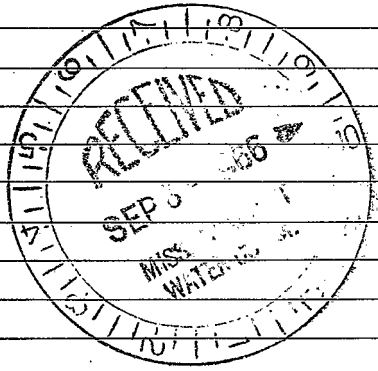

(Use Back Side)

Well No.

