

PRENTISS

471

7-24-70

MISSISSIPPI
BOARD OF WATER COMMISSIONERS
416 North State Street
Jackson, Mississippi 39201

CODED

WATER WELL DRILLERS LOG

7-24
date well completed

1969 Bondwell Drilling
firm name

Prentiss
county well located

LANDOWNER: Jerry Campbell

description of formations encountered

from

to

Booneville
(mailing address)

Red Clay	0	16
Blue Clay	16	180
Water sand	180	220

WELL LOCATION:

sec. 30 T-6 N R-8 E
 12 miles South of Booneville
 (distance) (direction) (nearest town)

WELL PURPOSE: Home
(home, irrigation, municipal, industrial)

CODED

WELL COMPLETION DATA:


- (1) diameter (inches) 4
- (2) total depth (feet) 220
- (3) static water level (feet) 100 below top of ground.
- (4) casing Steel (material) 2-1 (depth)
- (size) if telescope see back.
- (5) screen None (length) (depth to top)
- (size) (material)
- (6) pump (HP) (yield gpm)
- (type power)
- (7) electric log no (yes or no)
- (organization running log)
- (8) how well bottom plugged Open

DRILLERS REMARKS:

NOV 11 1969
 MISS. STATE
 WATER BOARD

If well telescopes please sketch and show depths.

GROUND LEVEL

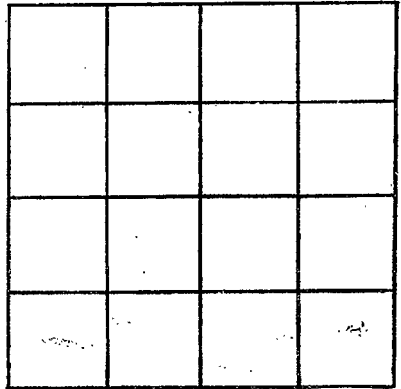

SECTION _____

Please indicate well location X.

ADDITIONAL INFORMATION

If more than one screen, show locations of each on sketch.