

PRENTISS

L 72

11-28-70

MISSISSIPPI BOARD OF WATER COMMISSIONERS
416 North State Street
Jackson, Mississippi 39201

CODED

WATER WELL DRILLERS LOG

11-28

date well completed

1970 Bonds Well Drilling

firm name

Prentiss

county well located

LANDOWNER: J. P. Allen

description of formations encountered

from to

Brownville Miss
(mailing address)

Mixed sand	0	74
Blue clay	74	88
Water sand	88	130

WELL LOCATION:

sec 36 T 6 N R 8

11 miles East of Brownville
(distance) (direction) (nearest town)

WELL PURPOSE: Farm
(home, irrigation, municipal, industrial)

WELL COMPLETION DATA:

- (1) diameter (inches) 4
- (2) total depth (feet) 130
- (3) static water level (feet) 36 below top of ground.
- (4) casing Steel 77 (material) (depth)

CODED

(size) if telescope see back.

- (5) screen none (length) (depth to top)

(size) (material)

- (6) pump 3/4 (HP) 5 (yield gpm)

Elect (type power)

- (7) electric log (yes or no)

(organization running log)

- (8) how well bottom plugged Open


DRILLERS REMARKS:

DEC 7 1970

MISS. BD. OF WATER COMMISSIONERS

If well telescopes please sketch and show depths.

GROUND LEVEL

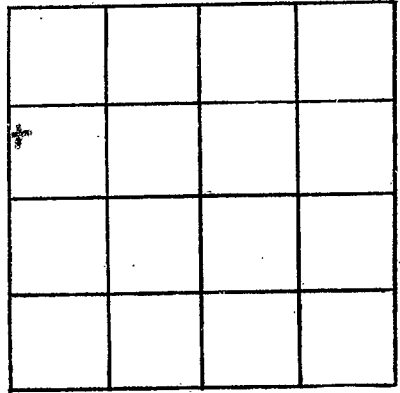

SECTION _____

Please indicate well location X.

ADDITIONAL INFORMATION

If more than one screen, show locations of each on sketch.