

PRENTISS

L 73

12-3-70

MISSISSIPPI
 BOARD OF WATER COMMISSIONERS
 416 North State Street
 Jackson, Mississippi 39201

CODED

WATER WELL DRILLERS LOG

12-3-70 date well completed
 Bomb Well Drilling, Inc. firm name
 Prentiss county well located

LANDOWNER: James M. ...
 HOUSE BURNED
 WELL NOT IN USE
 728-7238

description of formations encountered	from	to
Red clay	0	79
Red clay	79	133
Water sand	133	170

728763
 New Site
 (mailing address)

WELL LOCATION:
 sec. 11 T. 6 N. R. 8 E.
 S W
 11 miles East of Pearlville
 (distance) (direction) (nearest town)

WELL PURPOSE: Home
 (home, irrigation, municipal, industrial)

- WELL COMPLETION DATA:
- (1) diameter (inches) 4
 - (2) total depth (feet) 170
 - (3) static water level (feet) 60 below above top of ground.
 - (4) casing Steel 83 (material) (depth)
 (size) if telescope see back.
 - (5) screen none (length) (depth to top)
 (size) (material)
 - (6) pump 3/4 (HP) 5 (yield gpm)
 Electric pump (type power)
 - (7) electric log no (yes or no)
 (organization running log)
 - (8) how well bottom plugged open

CODED


JAN 7 - 1971

DRILLERS REMARKS:

MISS. BO. OF WATER

If well telescopes please sketch and show depths.

GROUND LEVEL

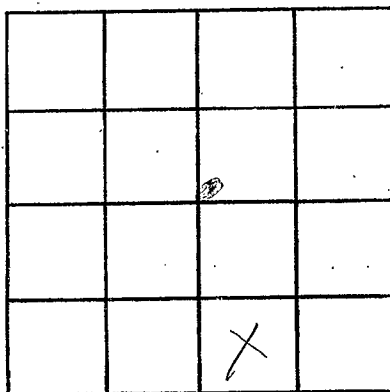

SECTION 11

Please indicate well location X.

ADDITIONAL INFORMATION

If more than one screen, show locations of each on sketch.