

PRENTISS
L 74
3-16-71

MISSISSIPPI
BOARD OF WATER COMMISSIONERS
416 North State Street
Jackson, Mississippi 39201

CODED

WATER WELL DRILLERS LOG

Boggs Well Drilling
Prentiss

3-16 date well completed 1971 firm name *JAMES FOUND* county well located

LANDOWNER: *James Found*
HW 30E 7285740
Brownville Miss.
(mailing address)

description of formations encountered	from	to
	<i>Red Clay</i>	<i>0</i>
<i>White sand</i>	<i>12</i>	<i>83</i>
<i>Water sand</i>	<i>83</i>	<i>126</i>

WELL LOCATION:
sec. 13 T. 7 N R. 8 E
17 miles S.E. of Brownville
(distance) (direction) (nearest town)

WELL PURPOSE: *Home*
(home, irrigation, municipal, industrial)

- WELL COMPLETION DATA:
- (1) diameter (inches) 4
 - (2) total depth (feet) 126
 - (3) static water level (feet) 32 below above top of ground.
 - (4) casing Steel (material) 126 (depth)
 - (5) screen proprietary Corin (length) (depth to top)
 - (6) pump 4 (size) Steel (material) 3/4 (HP) 5 (yield gpm)
 - (7) electric log Elect Pump (type power)
 - (7) electric log no (yes or no)
 - (8) how well bottom plugged plug

CODED


APR. - 6 1971

DRILLERS REMARKS:

MISS. BD. OF
WATER COM.

If well telescopes please sketch and show depths.

GROUND LEVEL

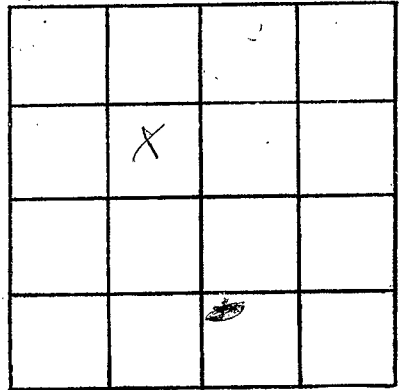

SECTION _____

Please indicate well location X.

ADDITIONAL INFORMATION

If more than one screen, show locations of each on sketch.