

Prentiss  
L75  
10-66

WATER WELL DRILLERS LOG **CODED**

Date: Oct 19, 1966, Driller: Bonds County: Prentiss

Turn Lt. on RD 1 mi

(Name)

(1) Owner of Land	Description & Color of Materials Sand, Clay, Red Clay, Shell, etc	Thick- ness Feet	Depth Feet
DWIGHT <u>White Sparks</u> (Name) <u>New Site, Miss</u> (Address)	<u>Red + yellow Sand</u> <u>Sandy blue</u> <u>white Water Sand</u>	<u>80</u> <u>30</u> <u>50</u>	<u>80</u> <u>110</u> <u>160</u>
(2) Location: <u>SE 1/4, NE 1/4, Sec. 26 To R 8E</u> <u>3</u> miles <u>South</u> , of <u>New Site</u> (distance) (direction) (Nearest Town)			
(3) Topography: <u>Hilly</u> (Hilly) (Flat) (Level)			
(4) Purpose of Well: <u>Domestic</u> (Domestic Irrigation Municipal, Industrial, Other)			

Information upon completion of well:


- (1) Diameter 4 inches.
- (2) Total Depth 160 feet.
- (3) Water Level 70 feet below top of ground.
- (4) Cased to 84, Size 4"
- (5) Screen: Size none Length \_\_\_\_\_
- (6) Were any formations sealed against pollution?  
 \_\_\_\_\_ yes, \_\_\_\_\_ no.

If YES depth of formation \_\_\_\_\_

Why \_\_\_\_\_

Drillers Remarks: \_\_\_\_\_

**CODED**

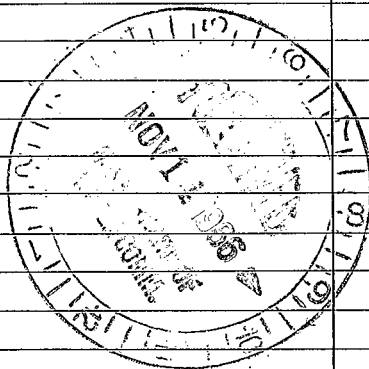

(Use Back Side)

Well No.

