

L76
4-30-62

WATER WELL DRILLERS LOG **CODED**

Date: April 30, 1962, Driller: HERNDON WELL & SUPPLY CO. County: Prentiss
 1st Lt. 2nd No 02 L P. O. BOX 42
 Name: SHANNON, MISSISSIPPI

(1) Owner of Land: <u>Kenith Maveland</u> (Name)	Description & Color of Materials Sand, Clay, Red Clay, Shell, etc.	Thick- ness Feet	Depth Feet
<u>Marietta Wheeler Miss</u> (Address) <u>32 650</u>	<u>Surface sand & clay</u>		<u>0</u>
(2) Location: <u>SE SESE 1/4, Sec 10, T. 20 N., R. 10 E.</u> <u>1</u> miles <u>N</u> of <u>Marietta</u> (distance) (direction) (Nearest Town)	<u>Blue rock</u>		<u>75</u>
(3) Topography: <u>flat</u> (Hilly) (Flat) (Level)	<u>sand</u>		<u>100</u>
(4) Purpose of Well: <u>Domestic</u> (Domestic Irrigation Municipal, Industrial, Other)	<u>to bottom</u>		<u>220</u>


Information upon completion of well:

- (1) Diameter 4 inches.
- (2) Total Depth 220 feet.
- (3) Water Level 40 feet below top of ground.
- (4) Cased to 30', Size 4"
- (5) Screen: Size ✓, Length ✓
- (6) Were any formations sealed against pollution?
✓ yes, _____ no.

If YES depth of formation 75'
Why Surface & Sand

Drillers Remarks: _____

CODED

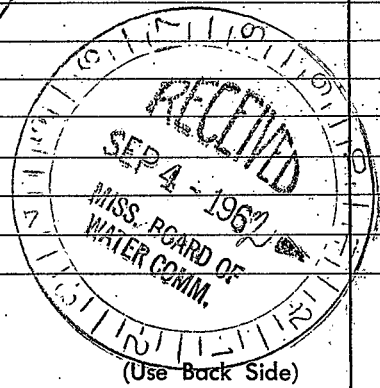

Well No.

1870

1871

1872

1900