

Prentiss

L78

12-66

MISSISSIPPI
 BOARD OF WATER COMMISSIONERS
 416 North State Street
 Jackson, Mississippi 39201

CODED

WATER WELL DRILLERS LOG

Dec 1, 1966 date well completed
 Bands Plumbing & Drilling Co. firm name
 2nd Ga. To Lt. 3rd 40 N E T
 Prentiss county well located

LANDOWNER: M. R. Fowler

Rt. 1

changed

description of formations encountered

from

to

Marietta, Miss (mailing address)

mixed sand & clay 0' 40'

Sandy blue 40' 100'

Water sand 100' 130'

WELL LOCATION:


29 sec. 4 T 6 N. R. 8 E
 1/2 miles N.W. of Marietta
 (distance) (direction) (nearest town)

WELL PURPOSE: Home
 (home, irrigation, municipal, industrial)

WELL COMPLETION DATA:

- (1) diameter (inches) 4"
- (2) total depth (feet) 130'
- (3) static water level (feet) 50' below top of ground.
- (4) casing BK steel, 1 1/2" (material) (depth)
- none (size) If telescope see back.
- (5) screen none (length) (depth to top)
- (size) (material)
- (6) pump none (HP) (yield gpm)
- (type power)
- (7) electric log NO (yes or no)
- (organization running log)
- (8) how well bottom plugged open

CODED

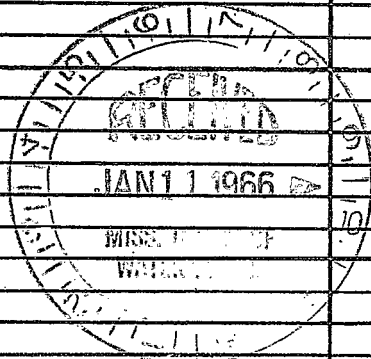

DRILLERS REMARKS:

If well telescopes please sketch and show depths.

GROUND LEVEL

			X

SECTION 29

Please indicate well location X.

ADDITIONAL INFORMATION

If more than one screen, show locations of each on sketch.