

PRENTISS

L79

4-28-61

WATER WELL DRILLERS

CODED

L300

Date: April 28, 1961, Driller: HERNDON WELL & SUPPLY CO. County: Prentiss

2nd Ga. Rd to Rt 15th WOODRT SHANNON, MISSISSIPPI

(1) Owner of Land: Caril Holley
 7085767 (Name)
 7284537 Boonville Miss
 (Address)
 (2) Location: S¹/₂ SE 1/4, SE 1/4, Sec. 2, T. 65 N. R. 8 E
 _____ miles _____ of Merietta,
 (distance) (direction) (Nearest Town)
 (3) Topography: Hilly
 (Hilly) (Flat) (Level)
 (4) Purpose of Well: Home use
 (Domestic Irrigation
 Municipal, Industrial, Other)

Description & Color of Materials Sand, Clay, Red Clay, Shell, etc.	Thick- ness Feet	Depth Feet
<u>Surface sand</u>		<u>0</u>
<u>and clay</u>		
<u>to</u>		
<u>Blue Rock</u>		<u>25</u>
<u>to</u>		
<u>Sand</u>		<u>42</u>
<u>to</u>		
<u>Bottom</u>		<u>140</u>


Information upon completion of well:

(1) Diameter 4 inches.
 (2) Total Depth 140 feet.
 (3) Water Level _____ feet below top of ground.
 (4) Cased to 32', Size 4"
 (5) Screen: Size _____, Length _____
 (6) Were any formations sealed against pollution?
yes, _____ no.

If YES depth of formation 29
 Why Surface & Sand

Drillers Remarks: _____

CODED

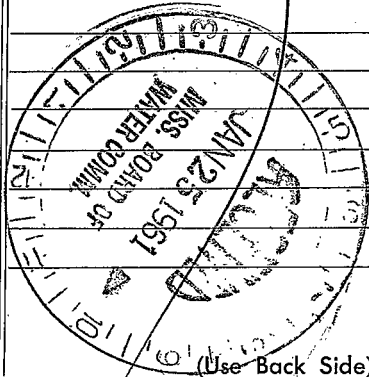

(Use Back Side)

Well No.

