

PRENTISS

L 82

9-26-73

MISSISSIPPI BOARD OF WATER COMMISSIONERS
416 North State Street
Jackson, Mississippi 39201

CODED 1973

MISS. BD. OF WATER COMMISSIONERS

WATER WELL DRILLERS LOG

9-26 date well completed

1973 Bombwell Drilling firm name

Prentiss county well located

LANDOWNER:

Silas Odle

Marietta, Miss (mailing address)

description of formations encountered

from

to

Red clay 0 32
Yellow Sand 32 55
Water Sand 55 107

WELL LOCATION:

sec. 1 T 7 N R 8 E
2 miles E of Marietta
(distance) (direction) (nearest town)

WELL PURPOSE: Home
(home, irrigation, municipal, industrial)

WELL COMPLETION DATA:

- (1) diameter (inches) 4
- (2) total depth (feet) 107
- (3) static water level (feet) 38 below top of ground.
- (4) casing Plastic, 107 (material) (depth)

CODED

- (5) screen Perforated (length) (depth to top)

- (6) pump 3/4 10 (HP) (yield gpm)


- (7) electric log 120 (yes or no)

- (8) how well bottom plugged plugged

DRILLERS REMARKS:

If well telescopes please sketch and show depths.

GROUND LEVEL

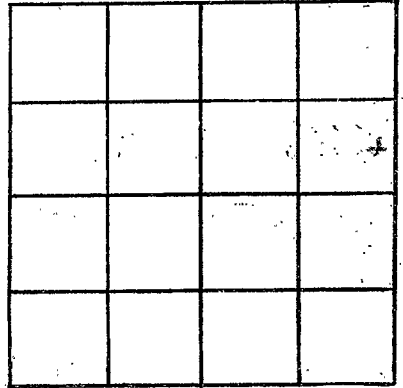

SECTION _____

Please indicate well location X.

ADDITIONAL INFORMATION

If more than one screen,
show locations of each on sketch.