

PRENTISS
L 83
9-26-73

MISSISSIPPI
BOARD OF WATER COMMISSIONERS
416 North State Street
Jackson, Mississippi 39201

OCT 19 1973
CODED

WATER WELL DRILLERS LOG


9-26 1973 Bonds Well Drilling Prentiss
date well completed firm name county well located

LANDOWNER:	description of formations encountered	from	to
Inez Pounds Marietta, Miss. (mailing address)	Red clay yellow sand Water sand	0 30 52	30 52 100
WELL LOCATION: sec. 1 T 7 N R 8 E 2 miles E of Marietta (distance) (direction) (nearest town)			
WELL PURPOSE: Home (home, irrigation, municipal, industrial)			
WELL COMPLETION DATA:			
(1) diameter (inches) 4			
(2) total depth (feet) 100			
(3) static water level (feet) 38 below top of ground.			
(4) casing Plastic, 100 (material) (depth)			
_____ If telescope see back. (size)			
(5) screen Perforated (length) (depth to top)			
4 (size) (material)			
(6) pump None (HP) (yield gpm)			
_____ (type power)			
(7) electric log No (yes/or no)			
_____ (organization running log)			
(8) how well bottom plugged plugged _____			
DRILLERS REMARKS:			

CODED

If well telescopes please sketch and show depths.

GROUND LEVEL

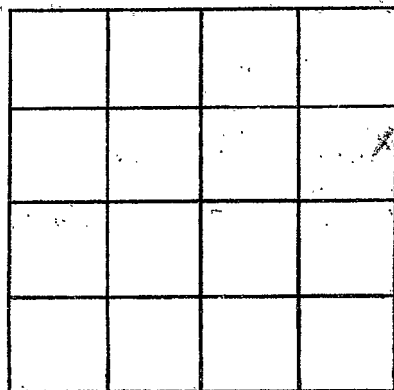

SECTION _____

Please indicate well location X.

ADDITIONAL INFORMATION

If more than one screen,
show locations of each on sketch.