

Prentiss
 L 86
 9/16/74

MISSISSIPPI
 BOARD OF WATER COMMISSIONERS
 416 North State Street JACKSON, MISSISSIPPI 39201

WATER WELL DRILLERS LOG

9/16 1974 Herman Homan Well & Supply, Inc. Prentiss
 date well completed office name county well located

LANDOWNER:	description of formations encountered	from	to
James Barks	Surface sand	0	23
At 4 Booneville Miss	clay	23	200
(mailing address)	Blue clay	80	200
	Sand	200	
	Bottom		

WELL LOCATION:
 sec. 32 T. 6 N. R. 8 E
 S W
 1 1/2 miles SW of Marietta
 (distance) (direction) (nearest town)

WELL PURPOSE: Home
 (home, irrigation, municipal, industrial)

- WELL COMPLETION DATA:
- (1) diameter (inches) 4 1/2
 - (2) total depth (feet) 200'
 - (3) static water level (feet) 90' below top of ground.
 - (4) casing Steel, 26' 3/4"
 (material) (depth)
 4" if telescope see back.
 (size)
 - (5) screen NO
 (length) (depth to top)
 (size) (material)
 - (6) pump 1/2 HP, 5 (yield gpm)
 electric (type power)
 - (7) electric log NO
 (yes or no)
 (organization running log)
 - (8) how well bottom plugged open

DRILLERS REMARKS:

SHANNON, MISSISSIPPI 38668


CODED

OCT - 8 1974

MISS. BD. OF WATER COMMISSIONERS

If well telescopes please sketch and show depths.

GROUND LEVEL

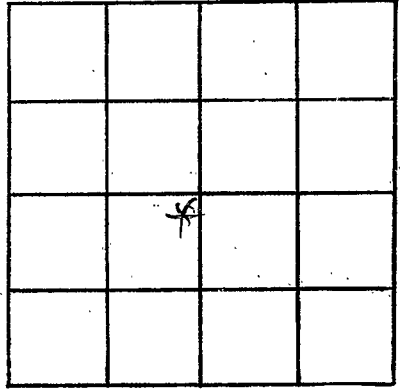

SECTION 32

Please indicate well location X.

ADDITIONAL INFORMATION

If more than one screen, show locations of each on sketch.