

Prentiss
L 87
8-11-75

MISSISSIPPI
 BOARD OF WATER COMMISSIONERS
 416 North State Street
 Jackson, Mississippi 39201

CODED

WATER WELL DRILLERS LOG

8-11 1975 Bushwell Drilling Prentiss
 date well completed firm name county well located

LANDOWNER: James Edward Bann
Booneville, Ms.
(Marietta)
 (mailing address)

description of formations encountered	from	to
<u>Red clay</u>	<u>0</u>	<u>17</u>
<u>yellow sand</u>	<u>17</u>	<u>59</u>
<u>Blue clay</u>	<u>59</u>	<u>84</u>
<u>Water Sand</u>	<u>84</u>	<u>130</u>

WELL LOCATION: 138
 sec 20 T 6 N R 8 E
2 1/2 miles N of Marietta
 (distance) (direction) (nearest town)

WELL PURPOSE: Home
 (home, irrigation, municipal, industrial)

- WELL COMPLETION DATA:
- (1) diameter (inches) 4"
 - (2) total depth (feet) 130'
 - (3) static water level (feet) 60 ^{below} _{above} top of ground.
 - (4) casing Steel, 63'
 (material) (depth)
 _____ If telescope see back.
 (size)
 - (5) screen NO
 (length) (depth to top)

 (size) (material)
 - (6) pump Handown
 (HP) (yield gpm)

 (type power)
 - (7) electric log NO
 (yes or no)

 (organization running log)
 - (8) how well bottom plugged open

CODED


DISCOVERED
 RECOVERED

SEP 24 1975

DRILLERS REMARKS:

If well telescopes please sketch and show depths.

GROUND LEVEL

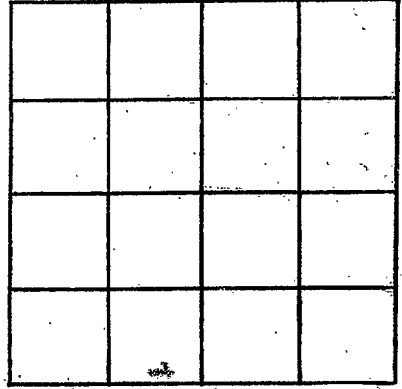

SECTION _____

Please indicate well location X.

ADDITIONAL INFORMATION

If more than one screen, show locations of each on sketch.