

Parton
L 88
3-21-75

MISSISSIPPI
 BOARD OF WATER COMMISSIONERS
 416 North State Street
 Jackson, Mississippi 39201

WATER WELL DRILLERS LOG

CODED

3-21 1975 Bonds Well Drilling Parton
 date well completed firm name county well located

LANDOWNER: John Morgan
Booneville
Mississippi
 (mailing address)

description of formations encountered	from	to
<u>Red clay</u>	<u>0</u>	<u>38</u>
<u>Blue clay</u>	<u>38</u>	<u>190</u>
<u>Water Sand</u>	<u>190</u>	<u>235</u>

WELL LOCATION:
 sec. 7 T. 6 N. R. 8 E. ^{13B}
4 miles ^(S) SE of Boo
 (distance) (direction) (nearest town)

WELL PURPOSE: Home
 (home, irrigation, municipal, industrial)

- WELL COMPLETION DATA:
- (1) diameter (inches) 4"
 - (2) total depth (feet) 235'
 - (3) static water level (feet) 100 ^(below) above top of ground.
 - (4) casing Steel, 42,
 (material) (depth)
 (size) If telescope see back.
 - (5) screen None,
 (length) (depth to top)
 (size) (material)
 - (6) pump Had own,
 (HP) (yield gpm)
 (type power)
 - (7) electric log NO
 (yes or no)
 (organization running log)
 - (8) how well bottom plugged open


CODED

RECEIVED
 SEP 24 1975

DRILLERS REMARKS:

If well telescopes please sketch and show depths.

GROUND LEVEL

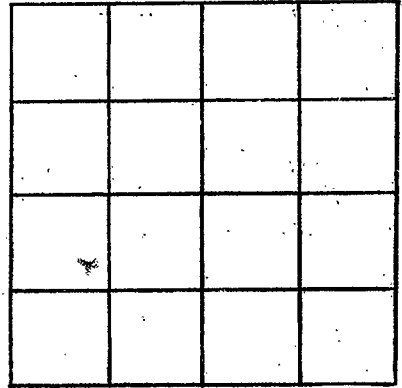

SECTION _____

Please indicate well location X.

ADDITIONAL INFORMATION

If more than one screen, show locations of each on sketch.