

MISSISSIPPI DEPARTMENT OF NATURAL RESOURCES
Bureau of Land and Water Resources
 Southport Mall
 P.O. Box 10631
 Jackson, Mississippi 39209
WATER WELL DRILLERS LOG

CODED

PRENTISS
L 91

12 September 19 86 Herndon Well & Supply Prentiss
 date well completed firm name county well located

LANDOWNER: Marietta Water Association	description of formations encountered	from	to
Marietta, MS (mailing address)	Red Sand	0	10
	Clay	10	18
	Sand	18	40
	Clay	40	50
	Sand w/Clay Streaks	50	100
	Gravel	100	150
	Clay	150	160
WELL LOCATION:			
sec. 4 T. 7 N R. 8 E S W			
Inside city limits			
(distance) miles (direction) of (nearest town)			
WELL PURPOSE: municipal			
(home, irrigation, municipal, industrial)			
WELL COMPLETION DATA:			
(1) diameter (inches) 12 x 6"			
(2) total depth (feet) 150'7"			
(3) static water level (feet) 40' below top of ground.			
(4) casing Steel 120' (material) (depth)			
12" If telescope see back. (size)			
(5) screen 30'7" 120' (length) (depth to top)			
6" SS Ribbed (size) (material)			
(6) pump 10 89.8 (HP) (yield gpm)			
electric (type power)			
(7) electric log yes (yes or no)			
Herndon Well (organization running log)			
(8) how well bottom plugged 6" BWV			
DRILLERS REMARKS:			

RECEIVED

FEB 12 1987

Department of Natural Resources
 Bureau of Land & Water Resources


If well telescopes please sketch and show depths.

GROUND LEVEL

Top of 8" Log
77' 7"

Top of 6" Screen
120'

B.W. Valve
150' 7"

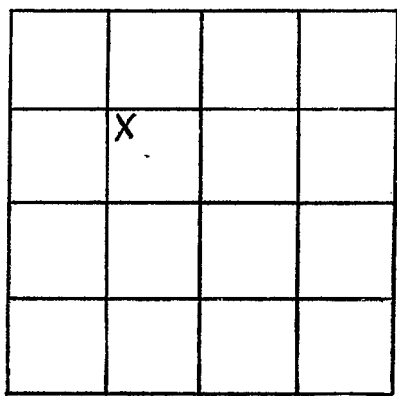

SECTION 4

Please indicate well location X.

ADDITIONAL INFORMATION

If more than one screen, show locations of each on sketch.