

MISSISSIPPI DEPARTMENT OF NATURAL RESOURCES
Bureau of Land and Water Resources
 Southport Mall
 P.O. Box 10631
 Jackson, Mississippi 39209
WATER WELL DRILLERS LOG

CODED

PRENTISS
L 92
10-27-86

10/27 19 86 Layne-Central Company Prentiss
 date well completed firm name county well located

LANDOWNER:	description of formations encountered	from	to
<u>New Site Water Associatio</u>			
<u>New Site, Mississippi</u> (mailing address)	Sand	10	25
WELL LOCATION: sec. <u>13</u> T <u>6</u> N R <u>8</u> <u>(S)</u> <u>(W)</u> <u>15</u> miles <u>SE</u> of <u>Booneville</u> (distance) (direction) (nearest town)	Blue clay	25	50
	Sandy clay	50	75
	Clay, few sand stks	75	110
	Clay	110	154
	Muddy sand	154	164
	Clay fine sand streaks	164	200
	Sand & gravel	200	207
	Rock	207	208
	Gravel	208	262
	Clay	262	266
Gravel	266	277	
Rock soft streaks	277	281	
CODED			
RECEIVED			
DEC 15 1986			
Department of Natural Resources Bureau of Land & Water Resources			

LANDOWNER:
New Site Water Associatio

New Site, Mississippi
 (mailing address)

WELL LOCATION:
 sec. 13 T 6 N R 8 (S) (W)
15 miles SE of Booneville
 (distance) (direction) (nearest town)


WELL PURPOSE: Municipal
 (home, irrigation, municipal, industrial)

- WELL COMPLETION DATA:**
- (1) diameter (inches) 10"
 - (2) total depth (feet) 264'
 - (3) static water level (feet) 66' below above top of ground.
 - (4) casing Steel, 217,
 (material) (depth)
10" if telescope see back.
 (size)
 - (5) screen 40', 222'
 (length) (depth to top)
6", stainless steel
 (size) (material)
 - (6) pump 20, 250
 (HP) (yield gpm)
Electric
 (type power)
 - (7) electric log Yes
 (yes or no)
Layne-Western Co.
 (organization running log)
 - (8) how well bottom plugged Cement

DRILLERS REMARKS:
Permit obtained by Owner.

If well telescopes please sketch and show depths.

GROUND LEVEL

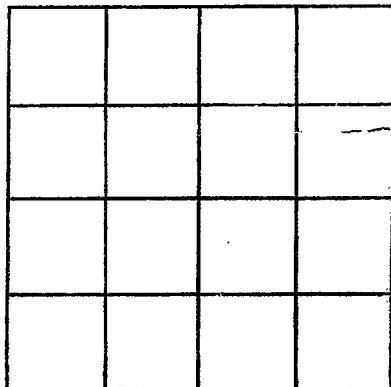

SECTION 4

Please indicate well location X.

ADDITIONAL INFORMATION

If more than one screen,
show locations of each on sketch.