

Prentiss  
 L 2001  
 7-67

MISSISSIPPI  
 BOARD OF WATER COMMISSIONERS  
 416 North State Street  
 Jackson, Mississippi 39201

WATER WELL DRILLERS LOG

July 14 1967 Bonds, Al H. Dillingham Prentiss  
 date well completed firm name county well located


LANDOWNER: Charles Price  
 Box 259  
 Marietta Miss  
 (mailing address)

description of formations encountered	from	to
Sandy Clay	0'	25'
Blue sand + Sandy Clay	22'	40'
Blue Clay	40'	125'
Water Sand	125'	200'

WELL LOCATION:  
 sec 30 T 4 N R 8 E  
 S W  
 3 miles NW of Marietta  
 (distance) (direction) (nearest town)

WELL PURPOSE: Home  
 (home, irrigation, municipal, industrial)


- WELL COMPLETION DATA:
- (1) diameter (inches) 4"
  - (2) total depth (feet) 246'
  - (3) static water level (feet) 120 below top of ground.
  - (4) casing (material) Bl steel, (depth) 42'
  - 4" (size) if telescope see back.
  - (5) screen none (length) (depth to top)
  - none (size) (material)
  - (6) pump 1 1/2 (HP) 5 (yield gpm)  
 Elect Jet (type power)
  - (7) electric log no (yes or no)  
 (organization running log)
  - (8) how well bottom plugged Open

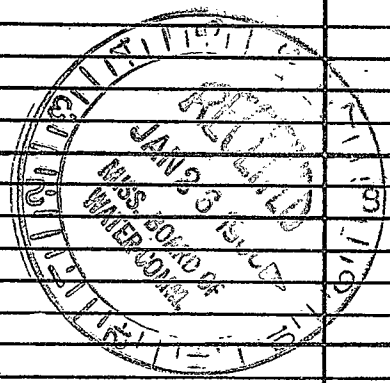

DRILLERS REMARKS:

If well telescopes please sketch and show depths.

GROUND LEVEL

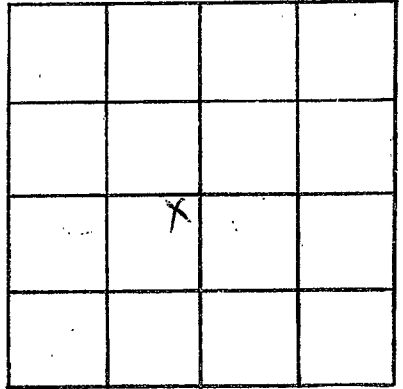

SECTION 30

Please indicate well location X.

ADDITIONAL INFORMATION

If more than one screen,  
show locations of each on sketch.