

PRENTISS  
 L2002  
 1-68

MISSISSIPPI  
 BOARD OF WATER COMMISSIONERS  
 416 North State Street  
 Jackson, Mississippi 39201

WATER WELL DRILLERS LOG

Jan. 30 1968 Bonds Plumbing & Drilling Co. Prentiss  
 date well completed firm name county well located


LANDOWNER: Walter Spencer  
Route 4  
Boonville, Miss  
 (mailing address)

description of formations encountered	from	to
<u>Sandy clay</u>	<u>0</u>	<u>44</u>
<u>blue clay</u>	<u>44</u>	<u>160</u>
<u>water sand</u>	<u>160</u>	<u>210</u>

WELL LOCATION:  
 sec. 7 T. 16 N R. 8 E  
S W  
6 1/2 miles SE of Boonville  
 (distance) (direction) (nearest town)

WELL PURPOSE: Home  
 (home, irrigation, municipal, industrial)


- WELL COMPLETION DATA:
- diameter (inches) 4"
  - total depth (feet) 210
  - static water level (feet) 100 <sup>below</sup>/<sub>above</sub> top of ground.
  - casing Steel, 4.5"  
 (material) (depth)  
~~4"~~ if telescope see back.  
 (size)
  - screen none  
 (length) (depth to top)  
none  
 (size) (material)
  - pump HP 1/2 horsepower  
 (type power) (yield gpm)
  - electric log none  
 (yes or no)  
 (organization running log)
  - how well bottom plugged open

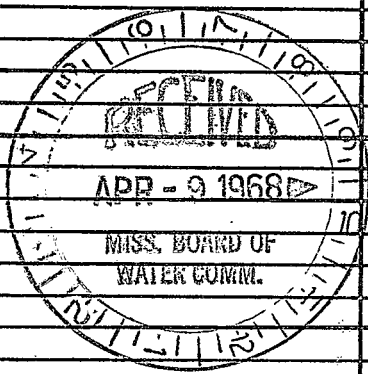

DRILLERS REMARKS:

If well telescopes please  
sketch and show depths.

GROUND LEVEL

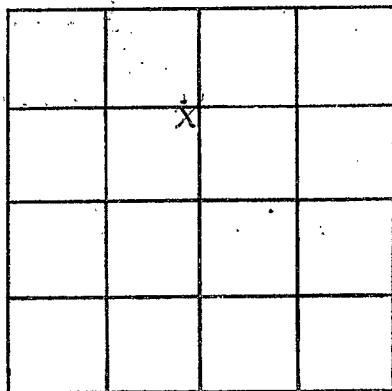

SECTION 7

Please indicate well location X.

ADDITIONAL INFORMATION

If more than one screen,  
show locations of each on sketch.