

PRENTISS  
 L 2003  
 3-68

MISSISSIPPI  
 BOARD OF WATER COMMISSIONERS  
 416 North State Street  
 Jackson, Mississippi 39201

WATER WELL DRILLERS LOG

March 14 1968 Bonds Plumbing & Drilling Prentiss  
 date well completed firm name county well located

LANDOWNER Earl Taylor

description of formations encountered	from	to
<u>Red Sandy Clay</u>	<u>0</u>	<u>19</u>
<u>Blue</u>	<u>19</u>	<u>120</u>
<u>water sand</u>	<u>120</u>	<u>134</u>

(mailing address)


WELL LOCATION:

sec. 2 T. 6 N R. 8 E  
3 1/2 miles N of New Site  
 (distance) (direction) (nearest town)

WELL PURPOSE: Home  
 (home, irrigation, municipal, industrial)

WELL COMPLETION DATA:

- (1) diameter (inches) 4
- (2) total depth (feet) 184
- (3) static water level (feet) 70 below above top of ground.
- (4) casing Steel, 2 1/2"  
 (material) (depth)  
4" If telescope see back.  
 (size)
- (5) screen none  
 (length) (depth to top)  
none  
 (size) (material)
- (6) pump HP  
1/2 (type power) (yield gpm)
- (7) electric log none  
 (yes or no)  
none  
 (organization running log)
- (8) how well bottom plugged Open

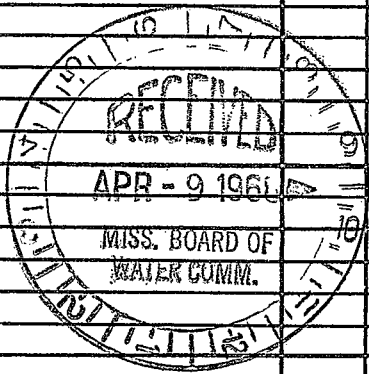

DRILLERS REMARKS:

If well telescopes please sketch and show depths.

GROUND LEVEL

	X		

SECTION 2

Please indicate well location X.

ADDITIONAL INFORMATION

If more than one screen, show locations of each on sketch.